


T. 1 S. R. 4 W. W. M.

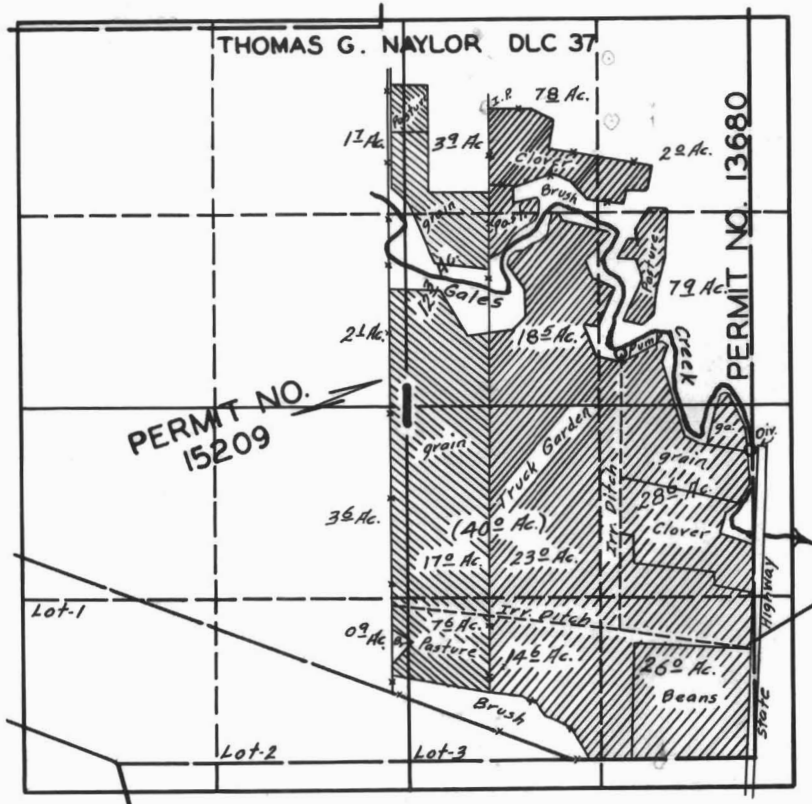

FINAL PROOF SURVEY

UNDER

Application No. 18008 13680
19636 Permit No. 15209

IN NAME OF

GEORGE L. HENDRICKS

Surveyed JULY 25 1944, by