


T.5N.,R.4W.,W.M.

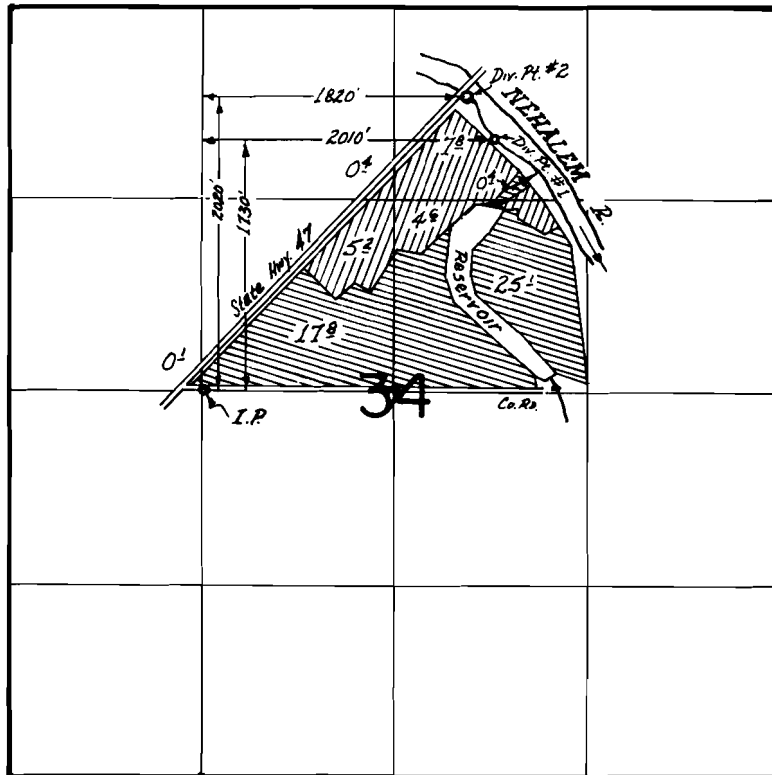

FINAL PROOF SURVEY
UNDER

Application No. 18089 Permit No. 13869
53919 40229


IN NAME OF

FRANK REED

Surveyed *Sept. 19* 1978, by *S.G. Applegate*

T.5N. R.4W.W.M.

SUPERCEDED
- see App # 55917
for new map

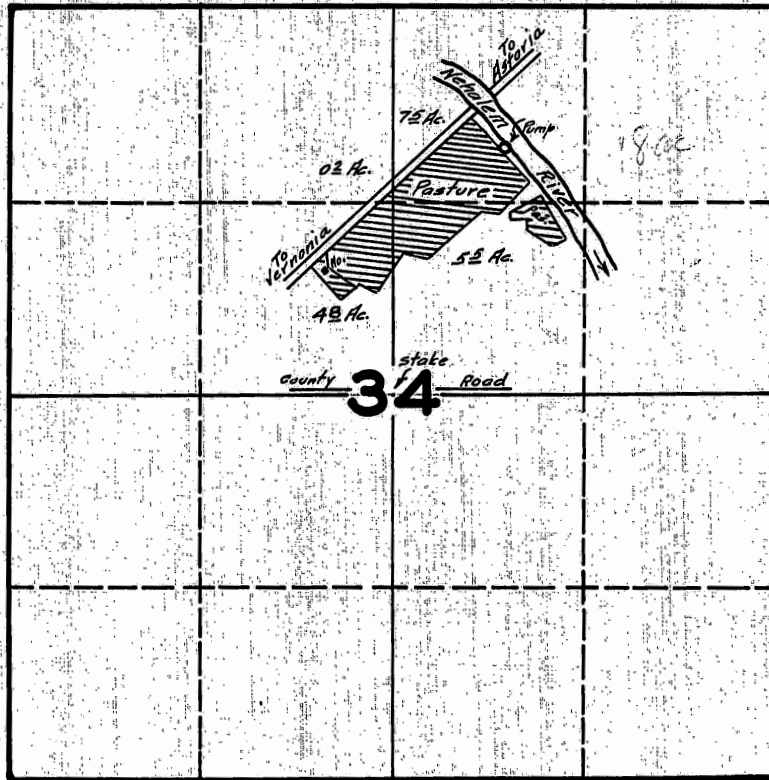

FINAL PROOF SURVEY
UNDER

Application No. 18089 Permit No. 13869

IN NAME OF

MATTHEW AND/OR HATTIE KING

Surveyed AUG 9 1944, by

A large, stylized handwritten signature, likely of the surveyor, is written over the text 'by' and extends across the bottom right of the page.