


# T. 2S. R. 1W. W.M.

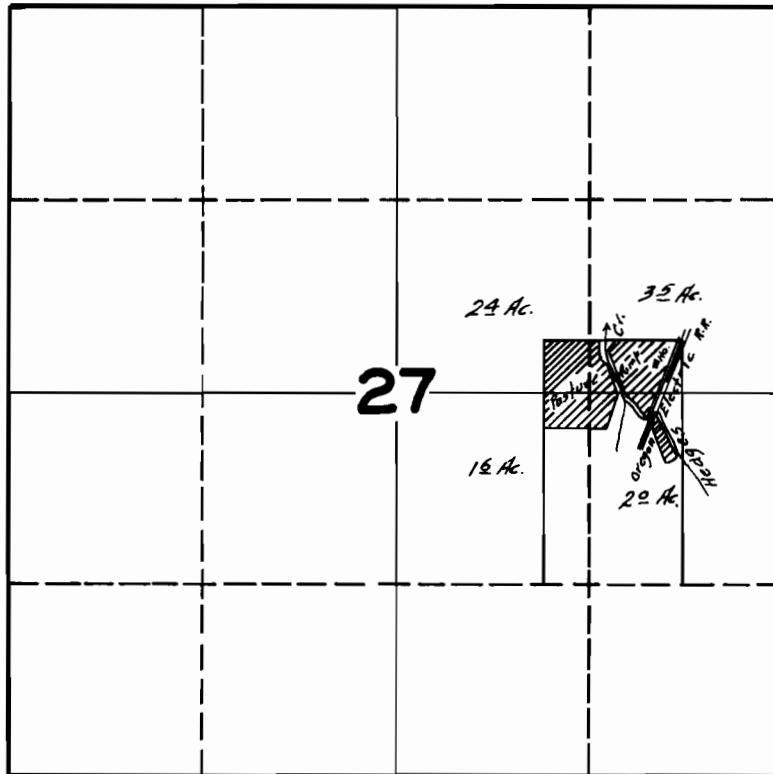

## FINAL PROOF SURVEY UNDER

Application No. 18811 Permit No. 14451

IN NAME OF

BRYAN B. TYKE SON

Surveyed AUG. 23 1944, by