


# T.7S. R.4W.W.M.

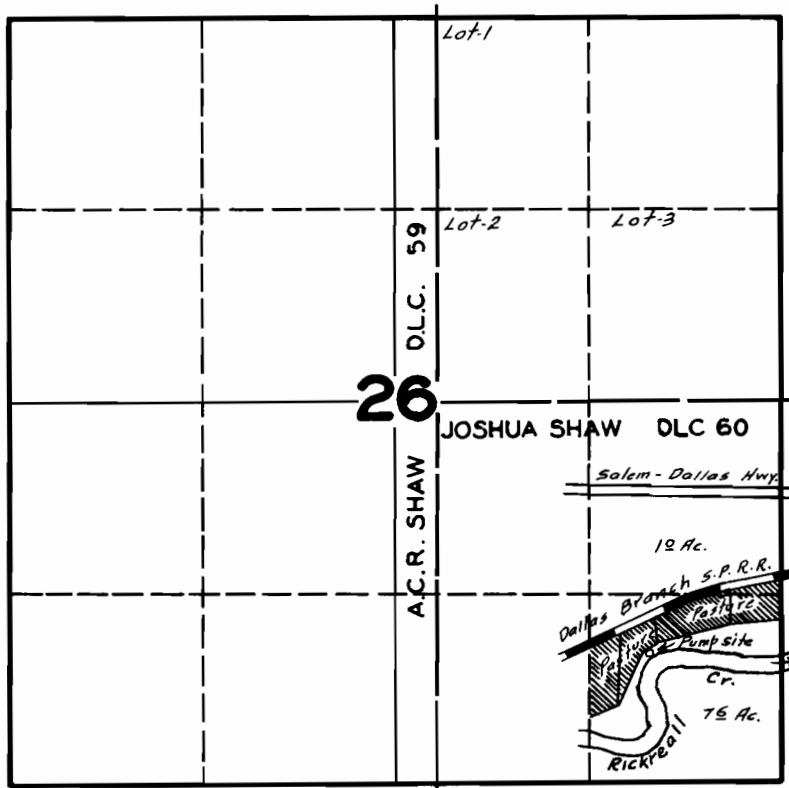

## FINAL PROOF SURVEY UNDER

Application No. 18953 Permit No. 14555

IN NAME OF

O.B. ALLM

Surveyed SEPT. 2, 1944, by

*James H. Russell*