


T.3S. R.1W.W.M.

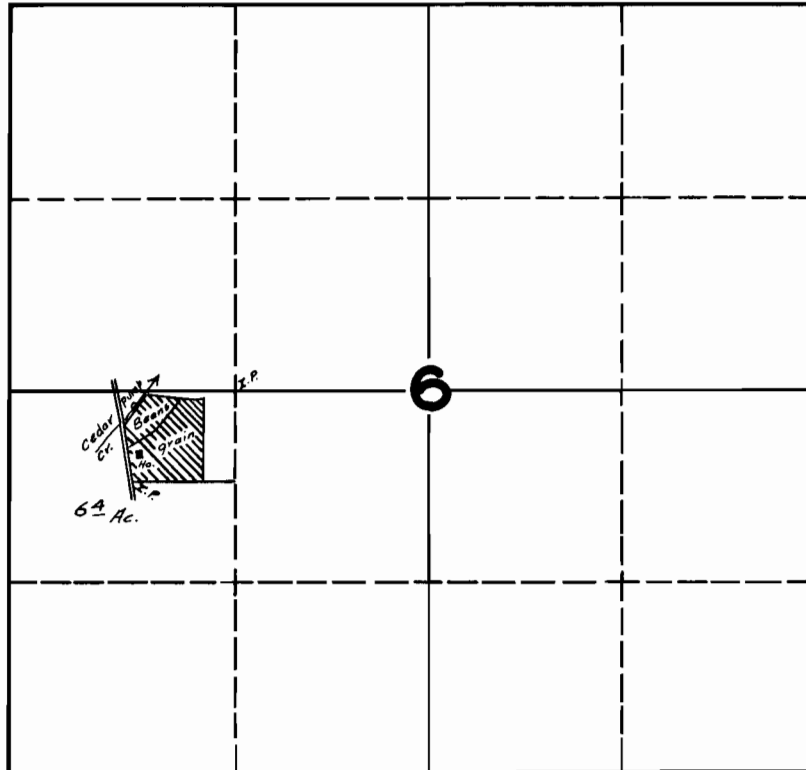

**FINAL PROOF SURVEY**  
UNDER

Application No. 18079 Permit No. 13744

IN FAVOR OF

**M. LA BROUSSE**

Surveyed AUG. 22 1944, by *James Sumner*