


T.7S. R.4W.W.M.

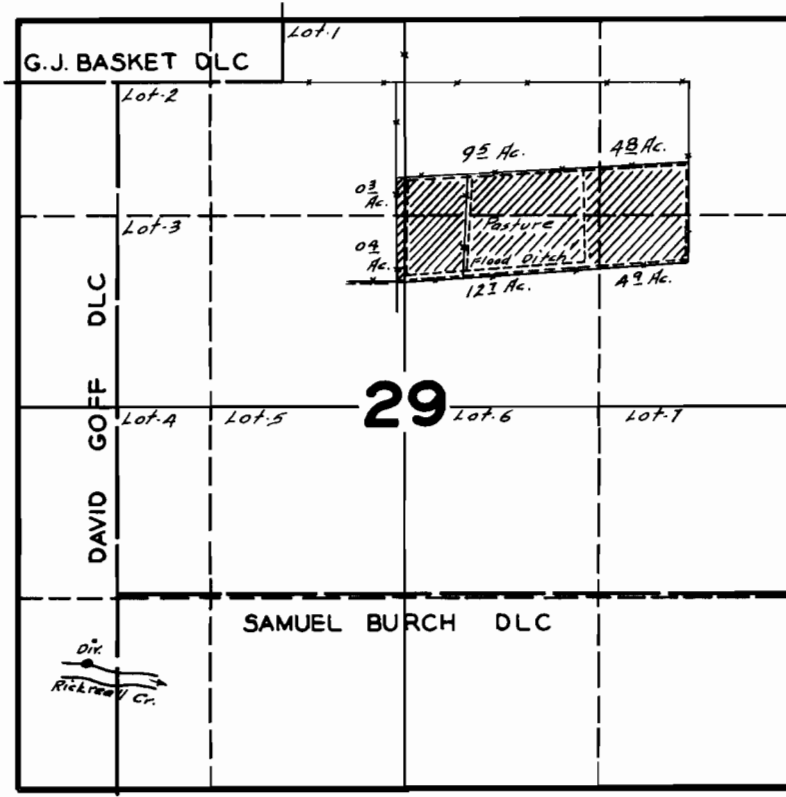

FINAL PROOF SURVEY

UNDER

Application No. 19183 Form No. 14780

IN FAVOR OF

M.C. FINDLEY

Surveyed JULY 21 1944, by *[Signature]*