


T.4S. R.3W.W.M.

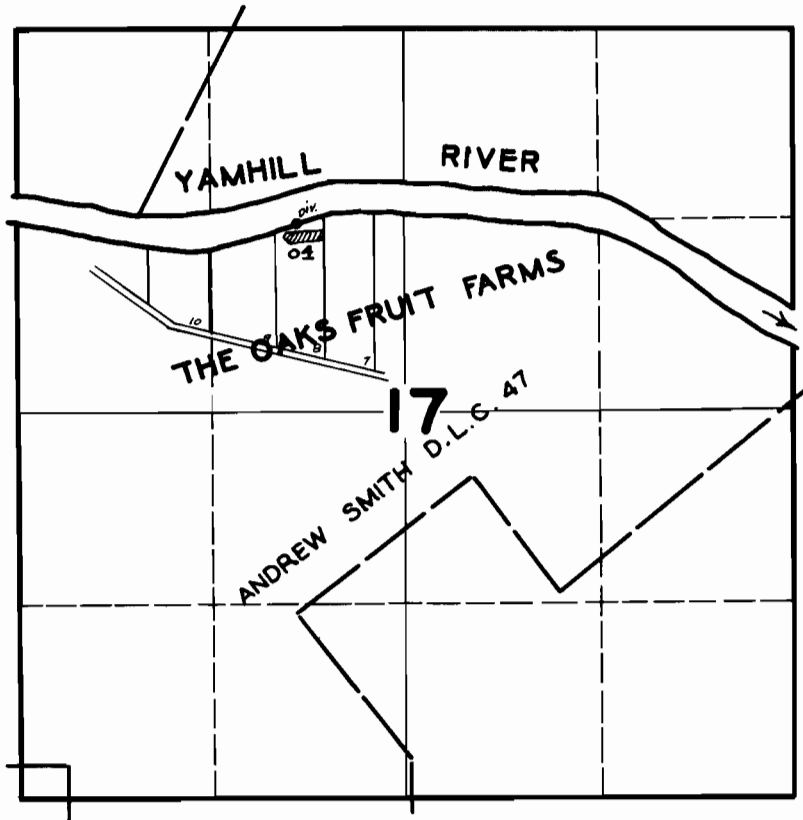

FINAL PROOF SURVEY UNDER

Application No. 18088 Permit No. 13750

IN NAME OF

H. G. COBURN

Surveyed JAN. 27, 1945, by