


T.3N. R.5W.W.M.

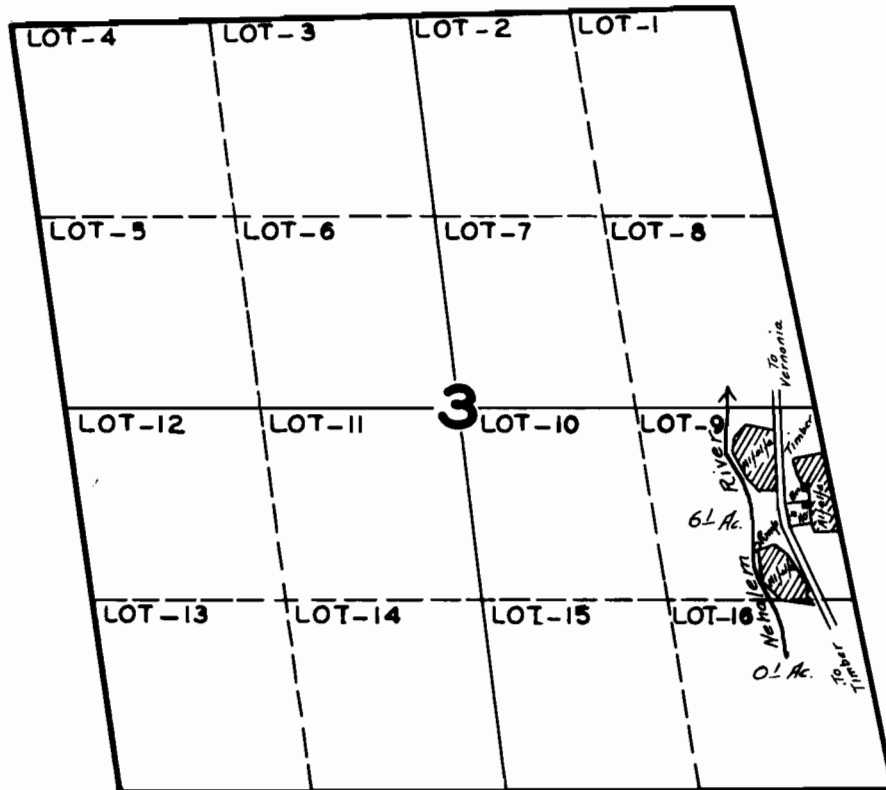

FINAL PROOF SURVEY
UNDER

Application No. 18108 Permit No. 13872

IN NAME OF
JOE BAKER

Surveyed AUG. 9, 1944, by

[Signature]