


T.2N. R.4W.W.M.

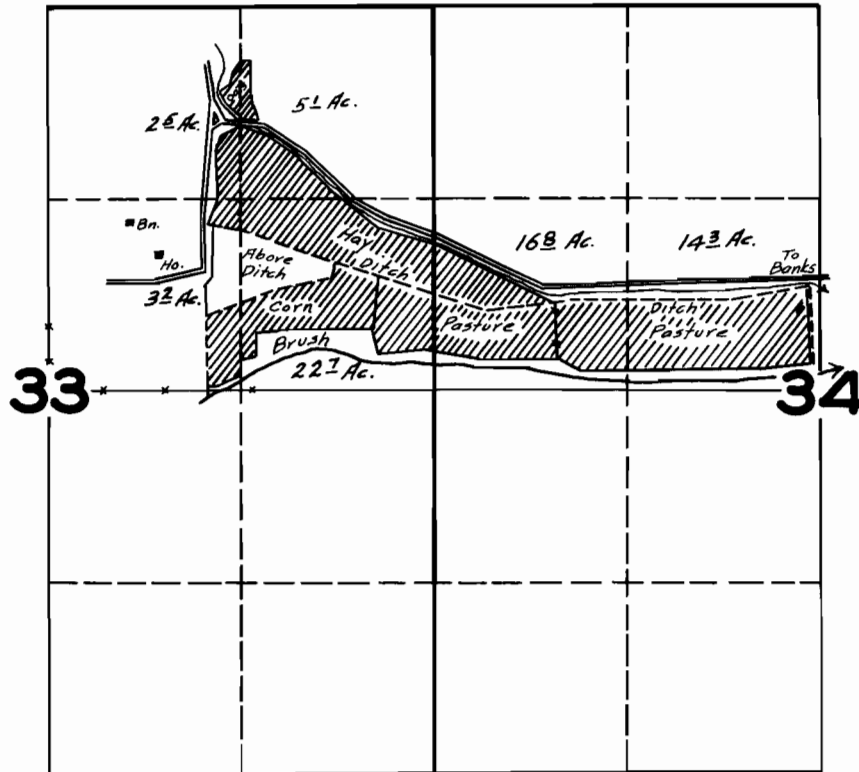

FINAL PROOF SURVEY UNDER

Application No. 18154 Permit No. 13797

IN NAME OF

JULIUS WINTERFIELD

Surveyed JULY 27 1944, by

J. Bunnell