


T.4S. R.3&4 W.W.M.

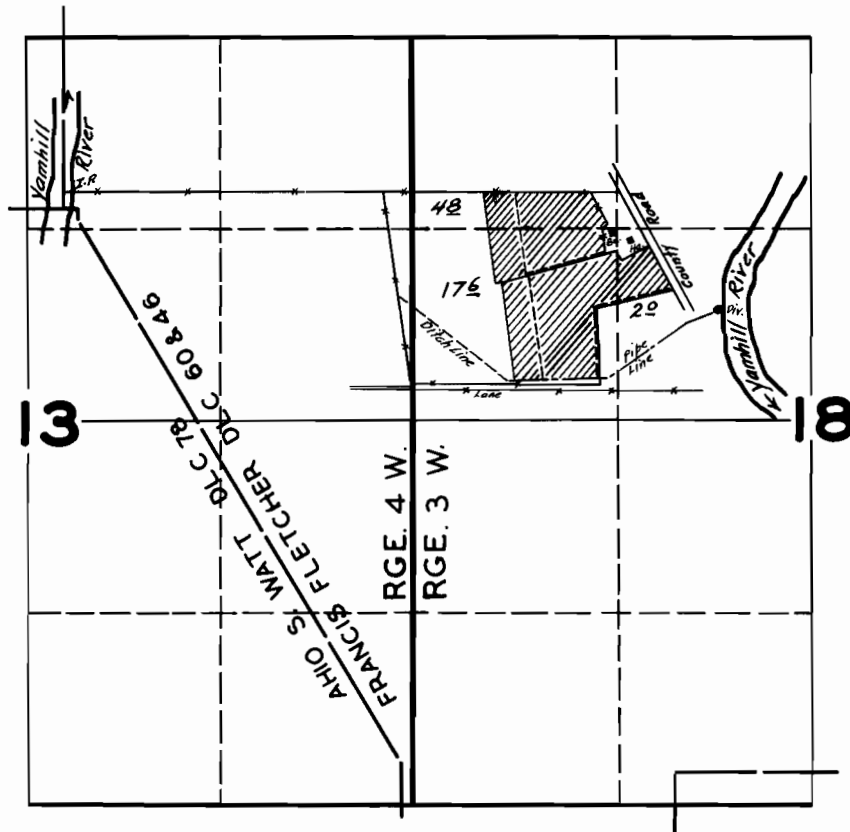

FINAL PROOF SURVEY UNDER

Application No. 18236 Permit No. 13897

IN NAME OF

UNITED STATES OF AMERICA

Surveyed JAN. 27 1945, by

[Handwritten Signature]