


T.2S. R.2W.W.M.

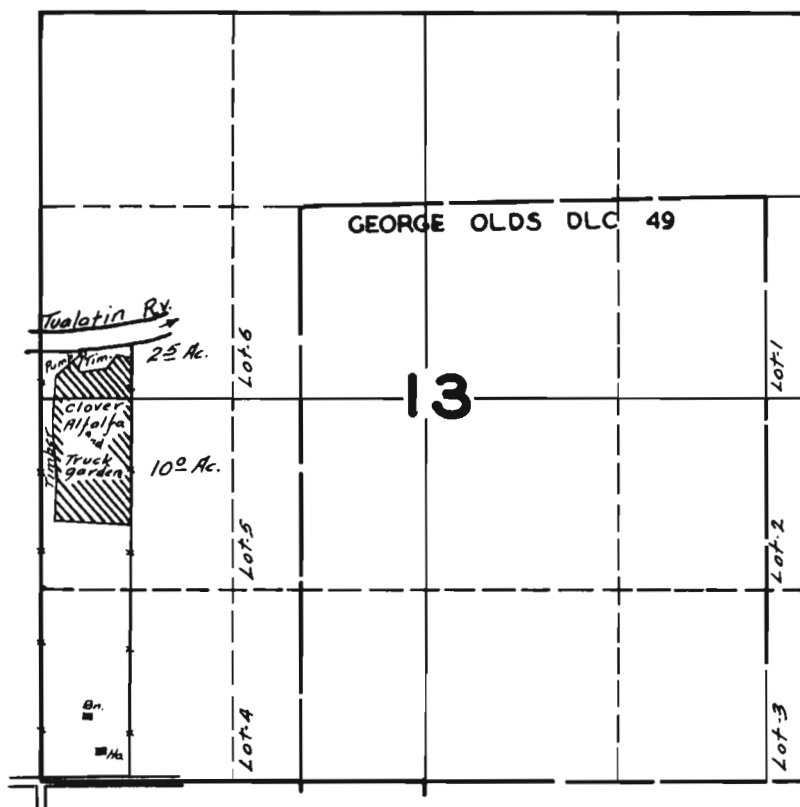

FINAL PROOF SURVEY UNDER

Application No. 18318 Permit No. 13954

IN NAME OF

WALTER FUHRER

Surveyed AUG. 22 1944, by