


# T.2S. R.5W.W.M.

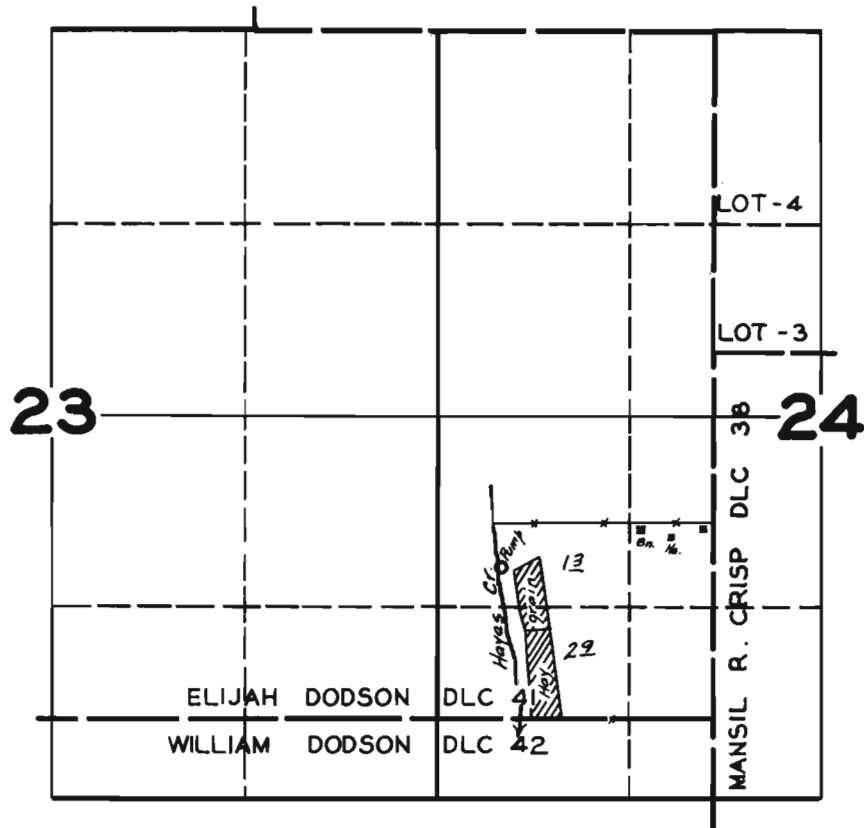

## FINAL PROOF SURVEY UNDER

Application No. 18334 Permit No. 13967

IN NAME OF

**L. & OLIVIA WILLIAMS**

Surveyed JUNE 27 1944, by *John P. Sumrell*