


T.4N. R.2W.W.M.

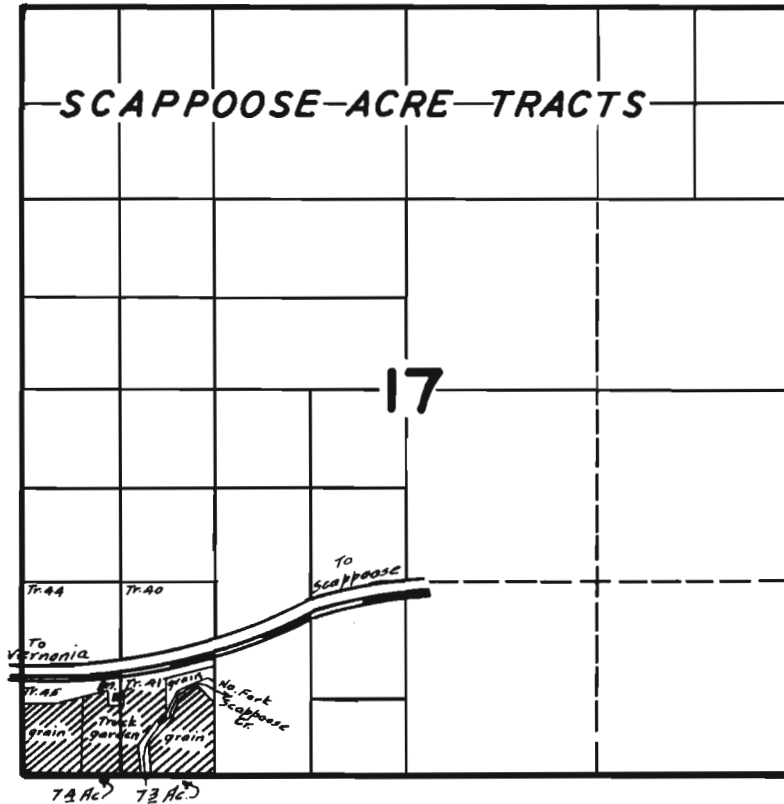

FINAL PROOF SURVEY UNDER

Application No. 18365 Permit No. 14016

IN NAME OF

ANTON URBON

Surveyed AUG. 8, 1944, by [Signature]