


T.5S. R.7W.W.M.

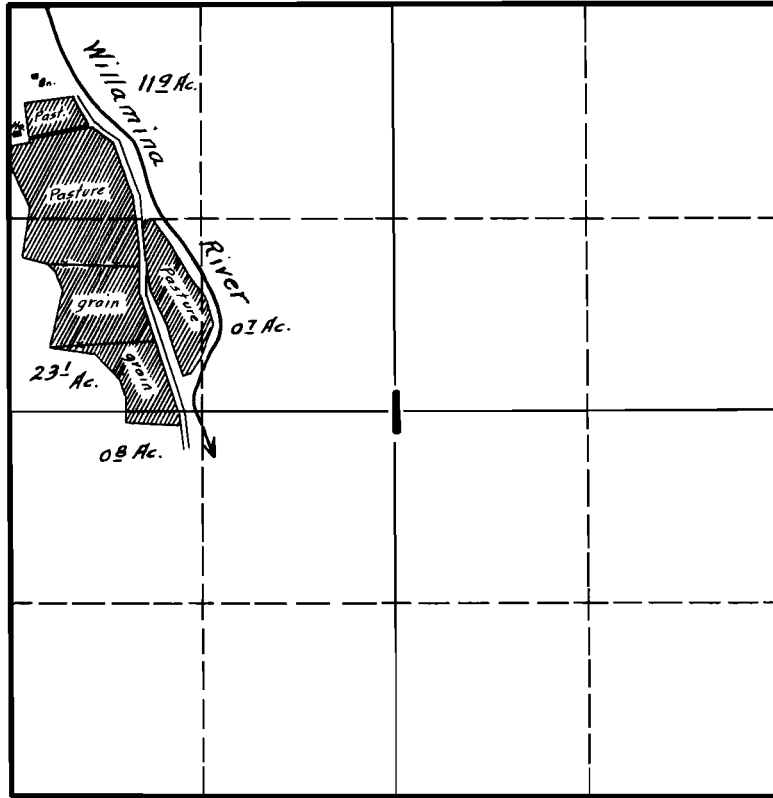

**FINAL PROOF SURVEY
UNDER**

Application No. J8449 Permit No. 14073

IN NAME OF
PHIL BOOTH

Surveyed MAR. 1 1946 by [Signature]