


T. 6 S., R. 1 W. W.M.

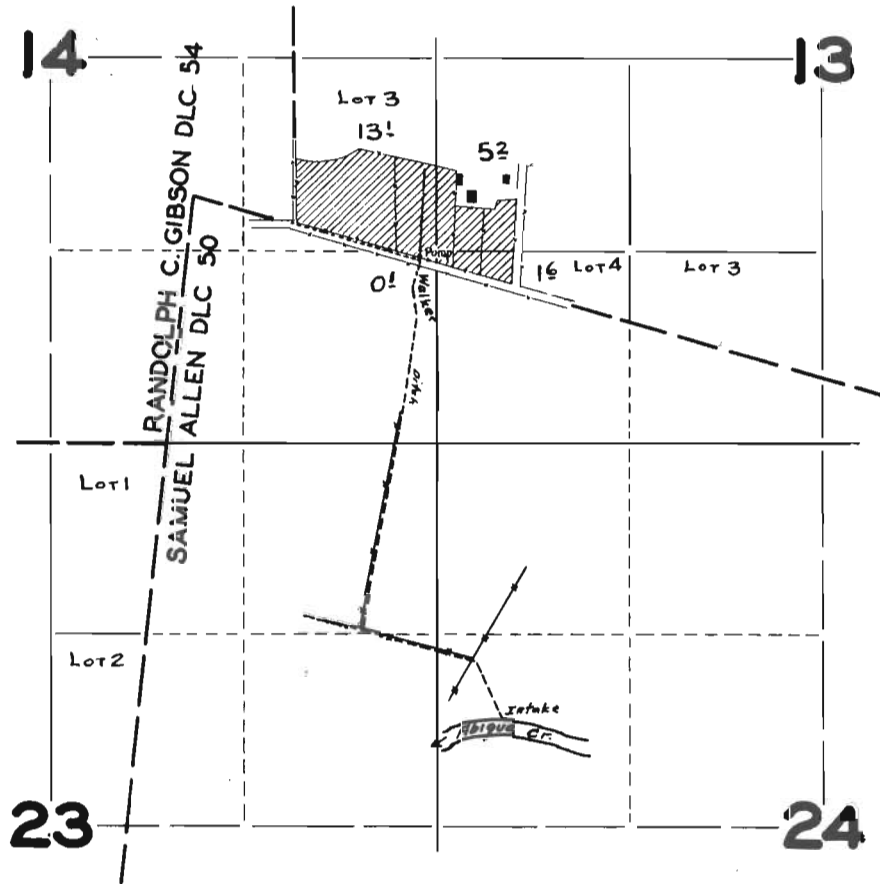

FINAL PROOF SURVEY
UNDER

Application No. 18559 Permit No. 14182

IN NAME OF

George H. Kruse

Surveyed Sept. 20 1943, by Geo. O. Aderman