


T.4&5N. R.4W.W.M.

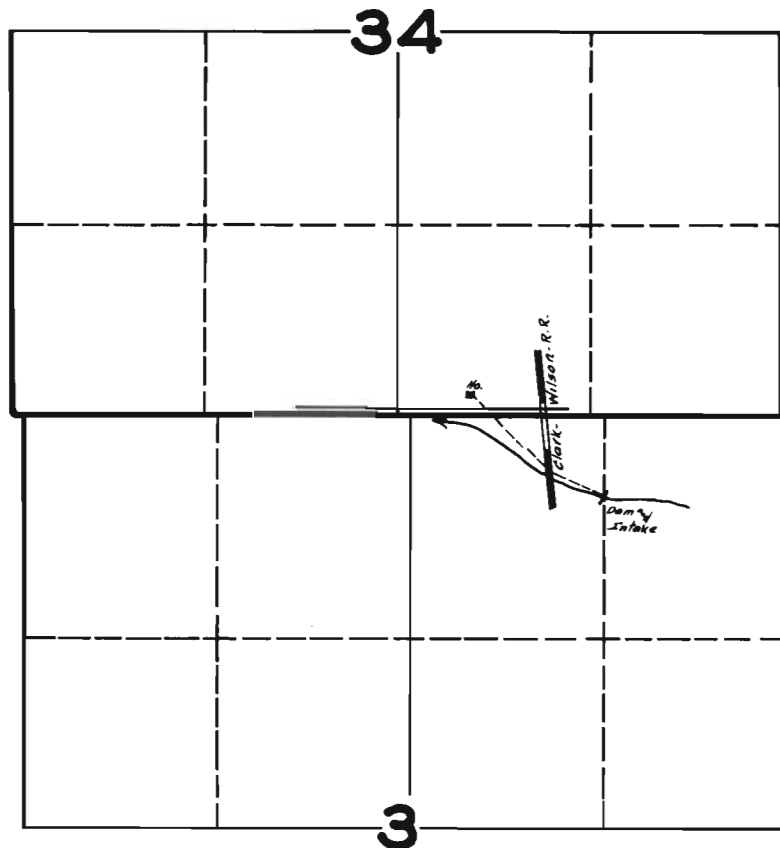

FINAL PROOF SURVEY
UNDER

Application No. 18580 Permit No. 14129

IN NAME OF

JOHN & MINNIE KERNICK

Surveyed AUG. 9 1944, by *James E. Russell*