


# T.6S. R.1W.W.M.

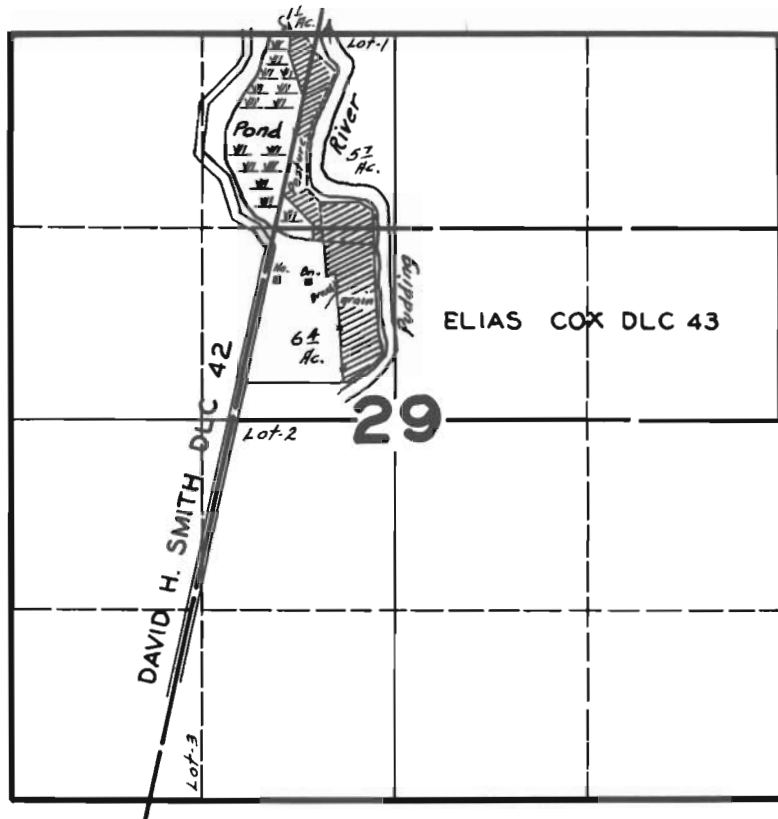

## FINAL PROOF SURVEY UNDER

Application No. 18557 Permit No. 14181

IN NAME OF

SILAS TORVEND, JR.

Surveyed DEC. 16 1944 by *[Signature]*