


T.2S. R.3&4W.W.M.

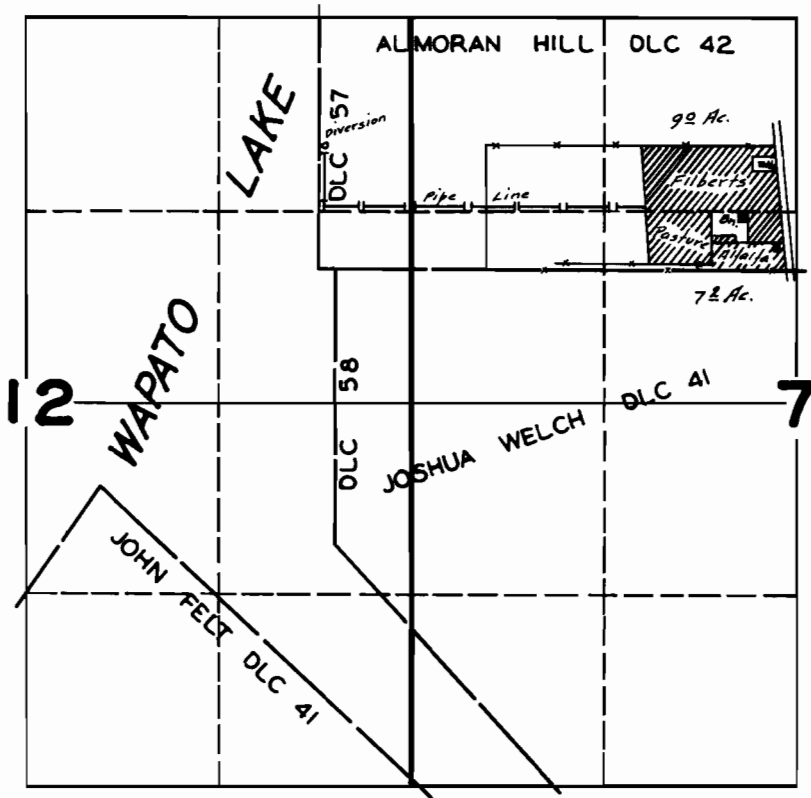

FINAL PROOF SURVEY UNDER

Application No. 18591 Permit No. 14194

IN NAME OF
RUSSELL KOPPLIN

Surveyed JULY 25 1944, by *James S. Summell*