


FROM OFFICE OF THE STATE ENGINEER, SALEM, OREGON


per July 1909
 State Engineer

Willow Creek Adjudication

2 S. 27 E
 Part 2 S. 28 E
 Part 3 S. 27 E

Township 2 S.

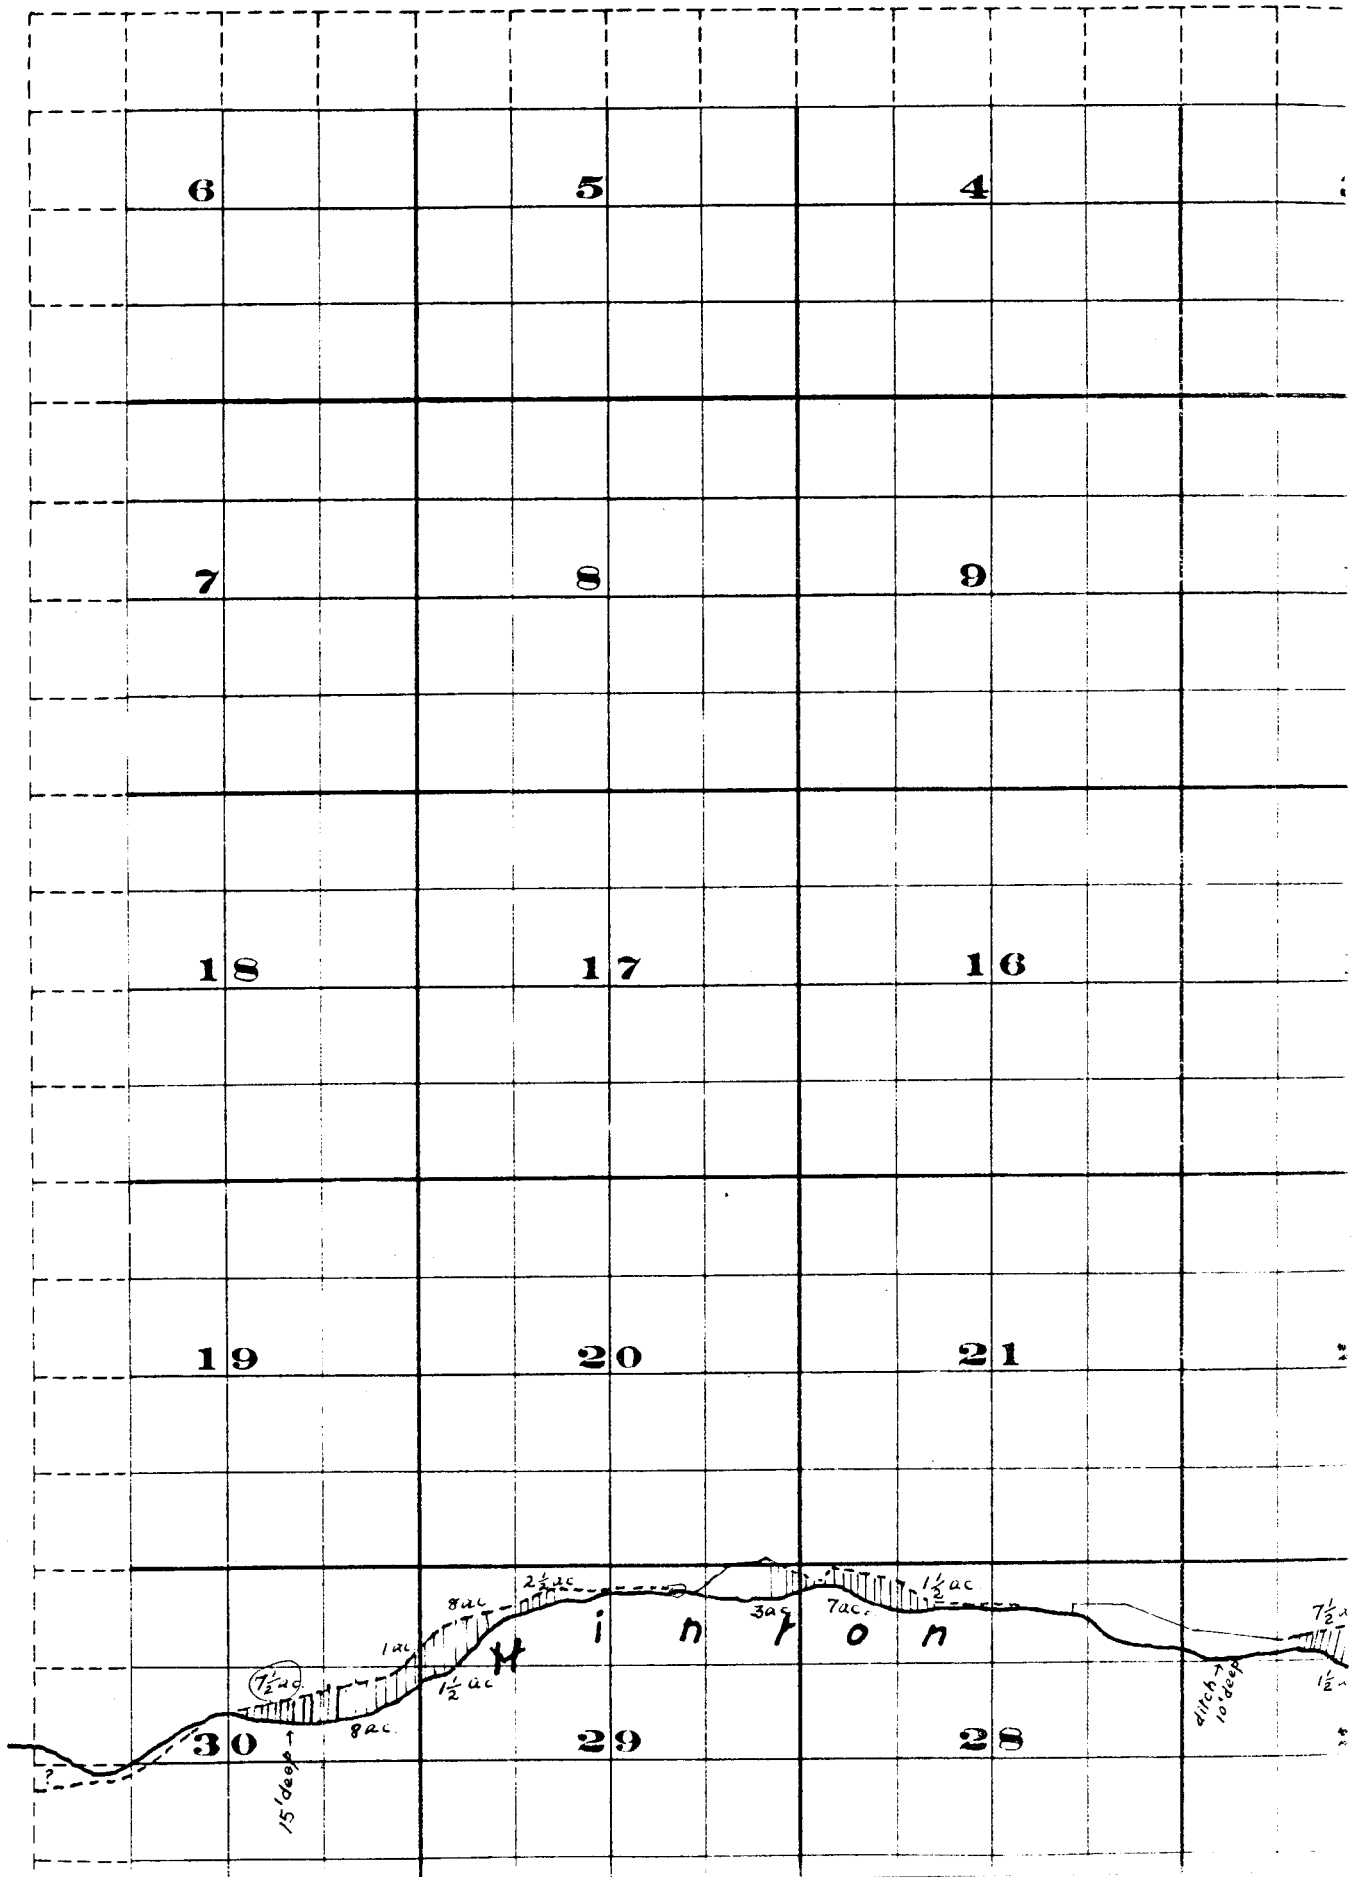

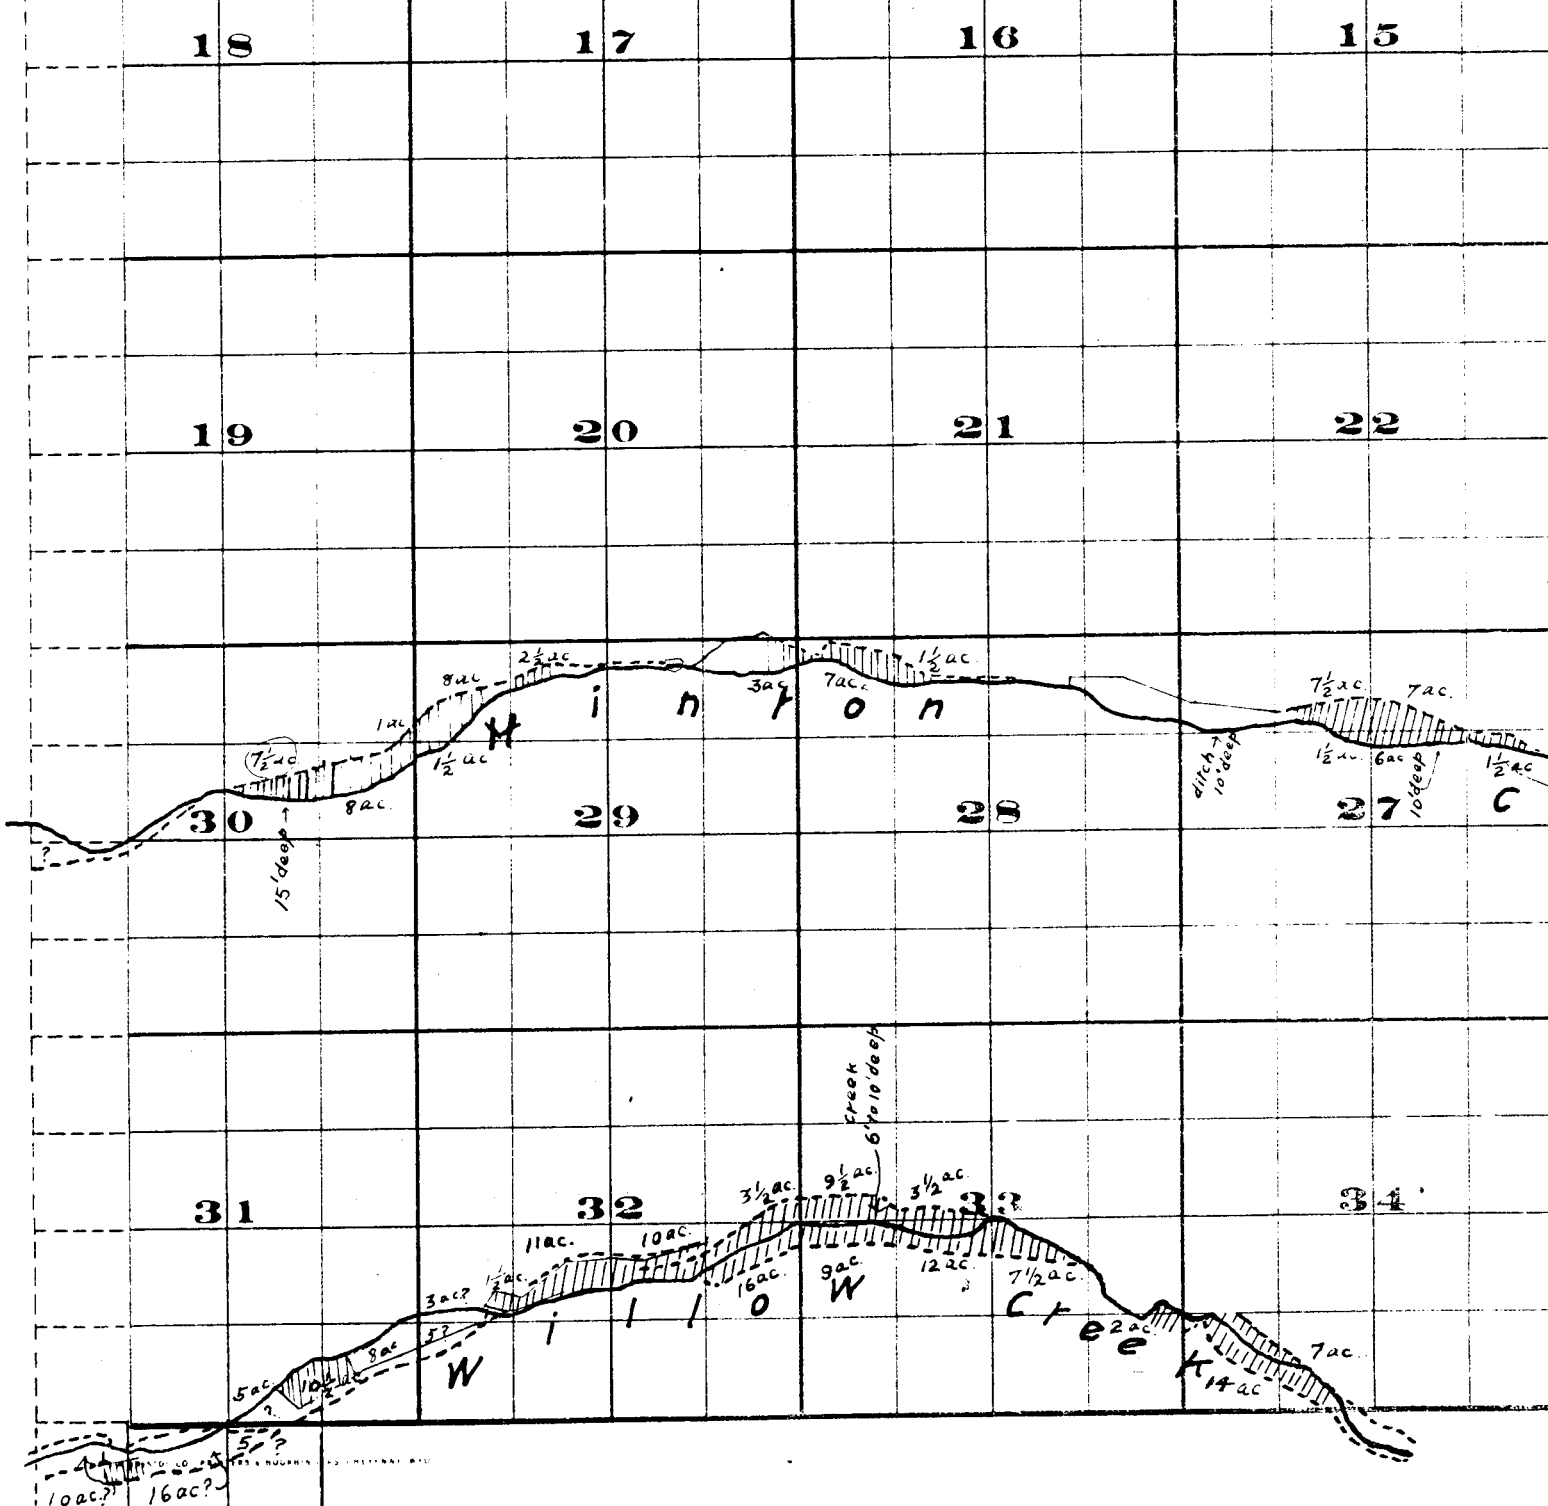

Surveyed by W. K. Donnelly & D. D. Cooper July
 John W. Lewis - State Engineer

Examined July 14, 1909.