


T.4S. R.1W.W.M.

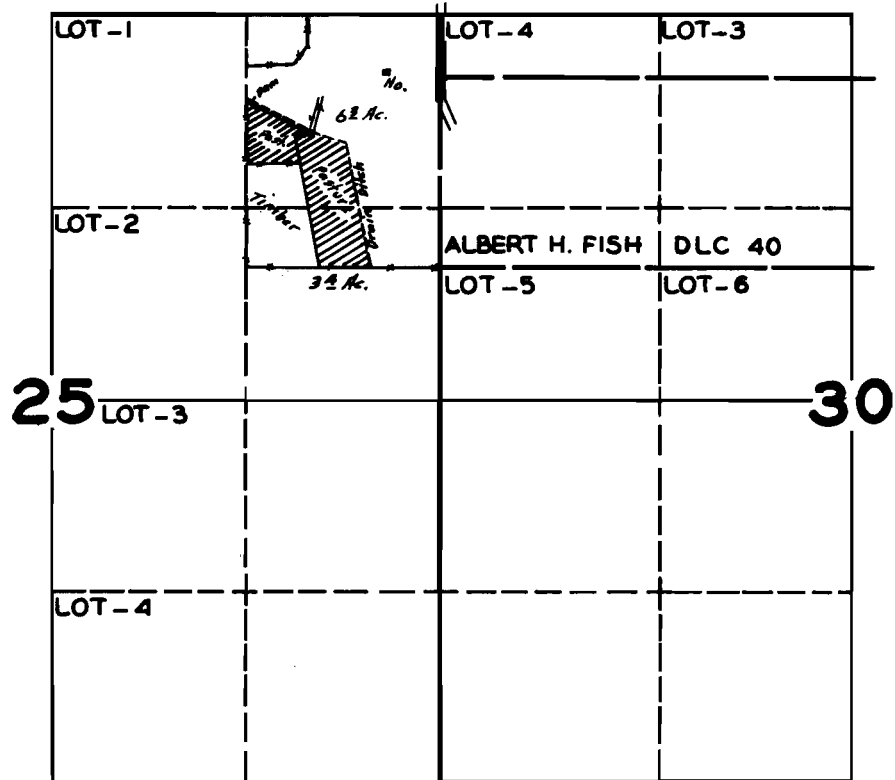

FINAL PROOF SURVEY UNDER

Application No. 18606 Permit No. 14198

IN FAVOR OF

FRED TRACHSEL

Surveyed JUNE 14 1944, by *[Signature]*