


T. 4S. R. 3W. W. M.

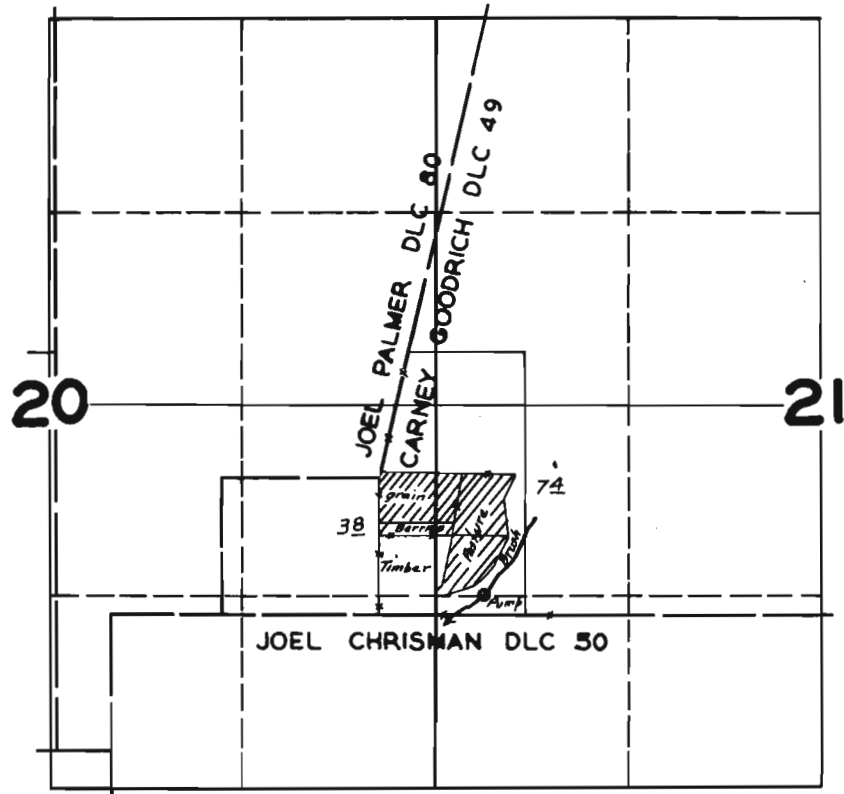

FINAL PROOF SURVEY UNDER

Application No. 18636 Permit No. 14271

IN NAME OF
V. H. THOMPSON

Surveyed JULY 12, 1944, by *J. H. Summell*