


T.3S. R.4E.W.M.

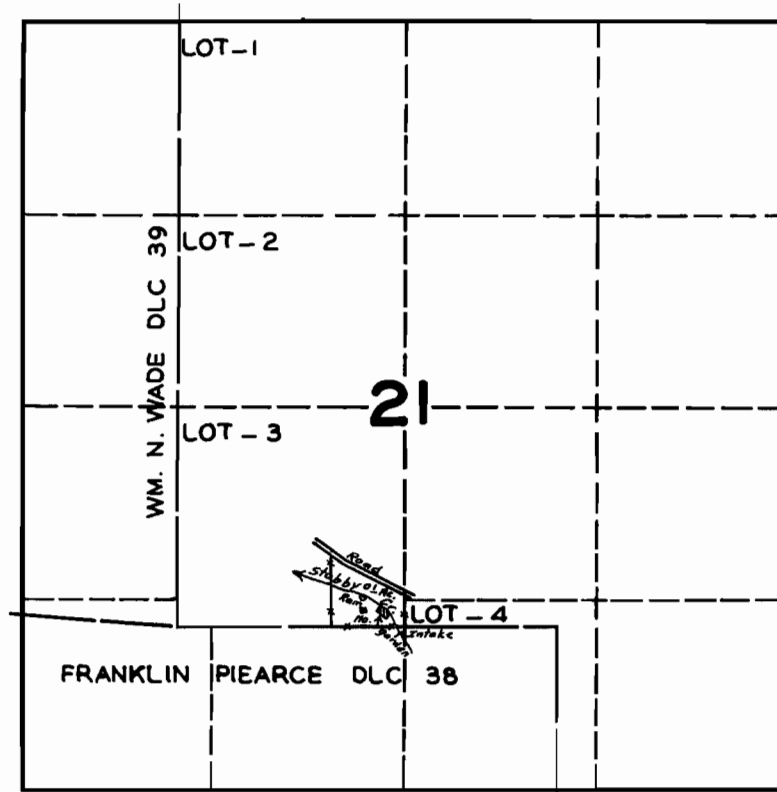

FINAL PROOF SURVEY UNDER

Application No. 18695 Permit No. 14321

IN NAME OF

J.L. CULVER

Surveyed AUG. 28 1944, by *James B. Sumrell*