


T.9S. R.2E.W.M.

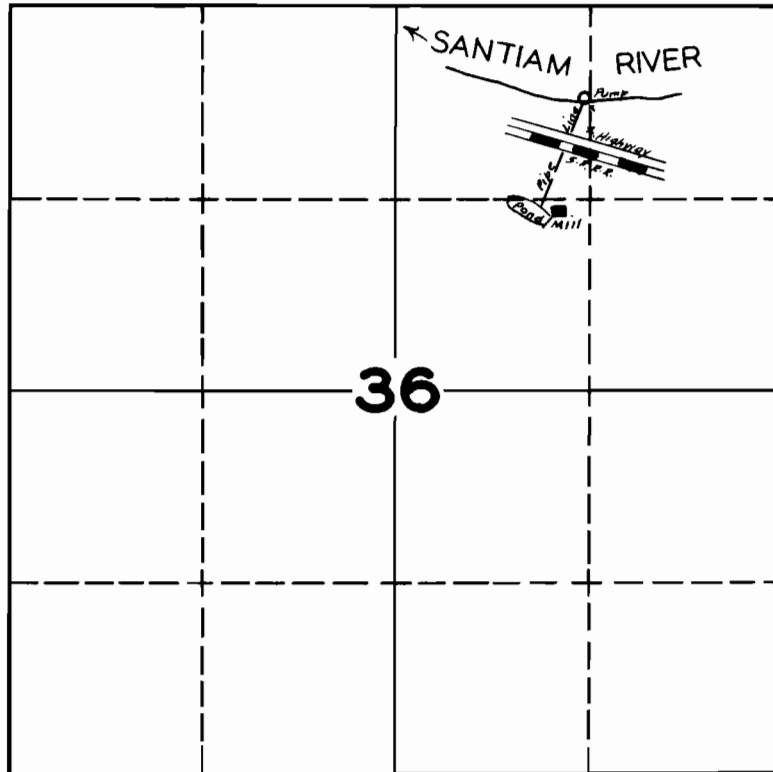

**FINAL PROOF SURVEY**  
UNDER

Application No. 18749 Permit No. 14358

IN NAME OF  
**MILL CITY LUMBER COMPANY**

Surveyed SEPT. 11 1944, by

*Paul Sumner*