


T 7 S. R 1 W. W.M.

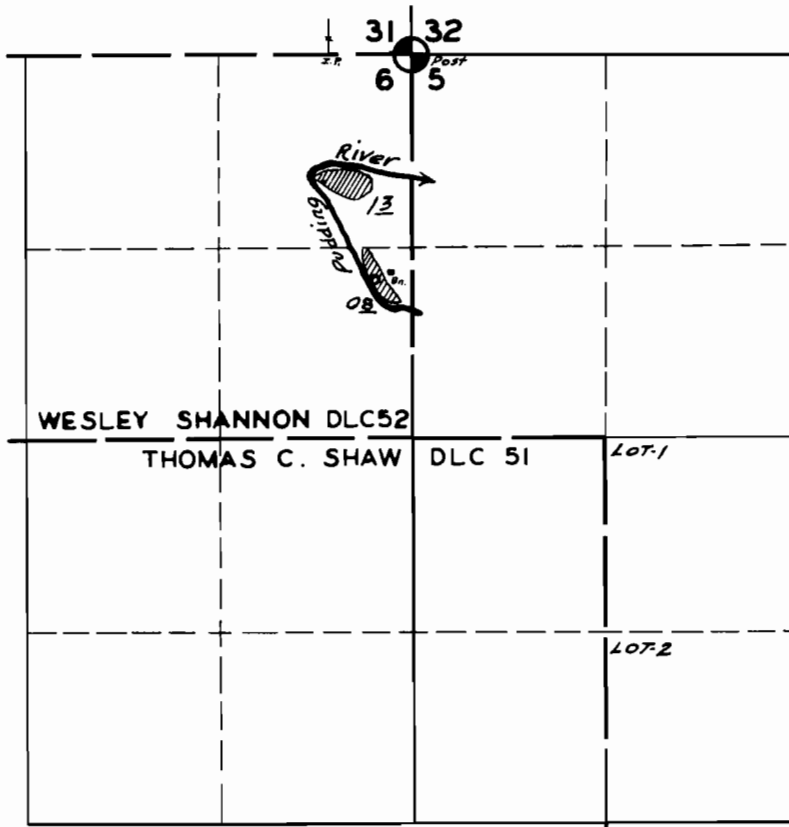

FINAL PROOF SURVEY UNDER

Application No. 18762 Permit No. 14365

IN NAME OF

KARL DETTWYLER

Surveyed JUNE 6 1944, by