


T.8S. R3W. W.M.

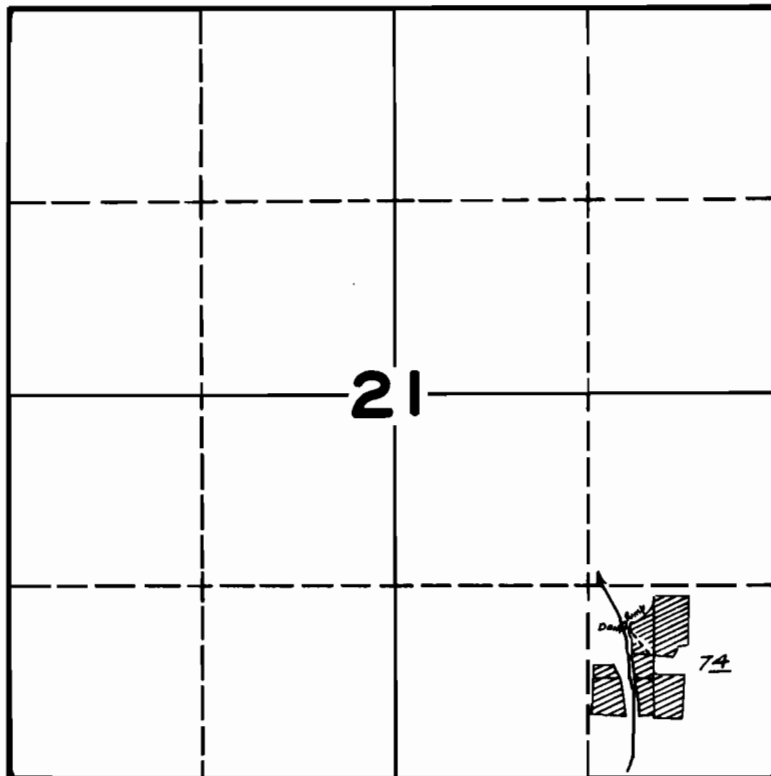

**FINAL PROOF SURVEY
UNDER**

Application No. 18886 Permit No. 14390

IN NAME OF

FORREST CAMMACK

Surveyed JUNE 5 1944, by James R. Sumner