T.3&4S. R.4W. W.M.

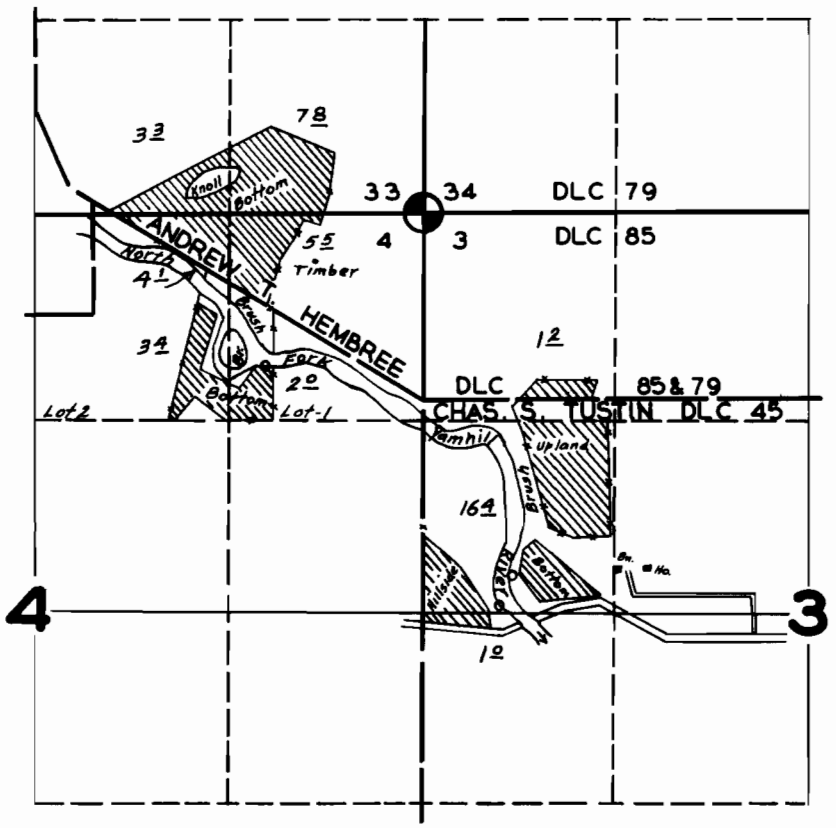

FINAL PROOF SURVEY

UNDER

Application No. 17819 Permit No. 13491

IN NAME OF

JOHN KIRSCH

Surveyed JULY 7 1944, by [signature]

1944-C