


T.3S. R.2W.W.M.

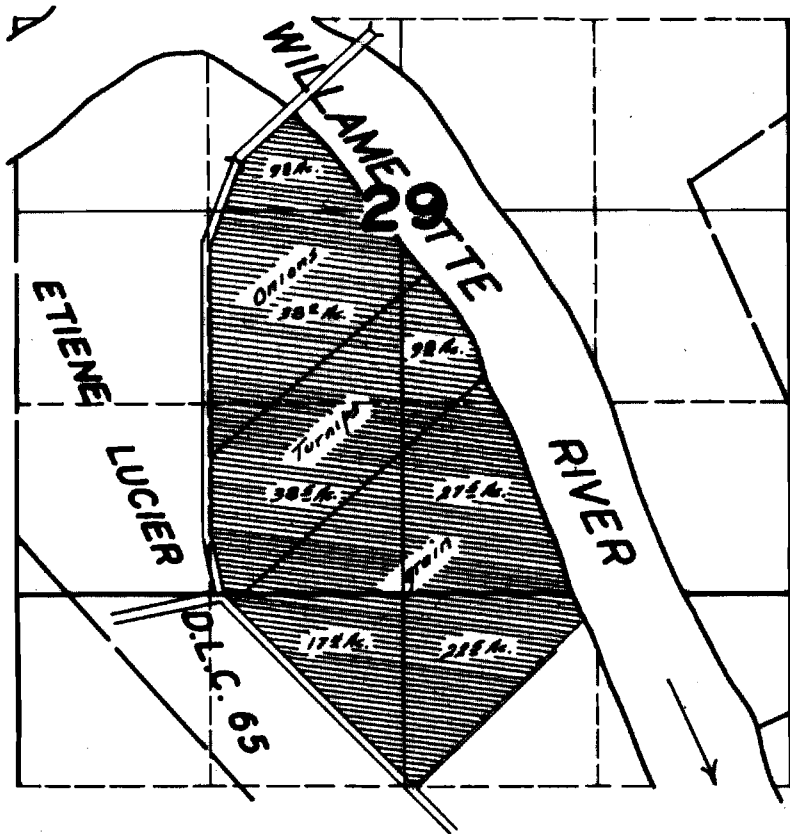

FINAL PROOF SURVEY
UNDER

Application No. 18657 Permit No. 14289

IN NAME OF

WALTER T. & CECIL C. SMITH

Surveyed AUG. 25 1944, by *W. H. Russell*