


T. 10 S. R. 2 W. W.M.

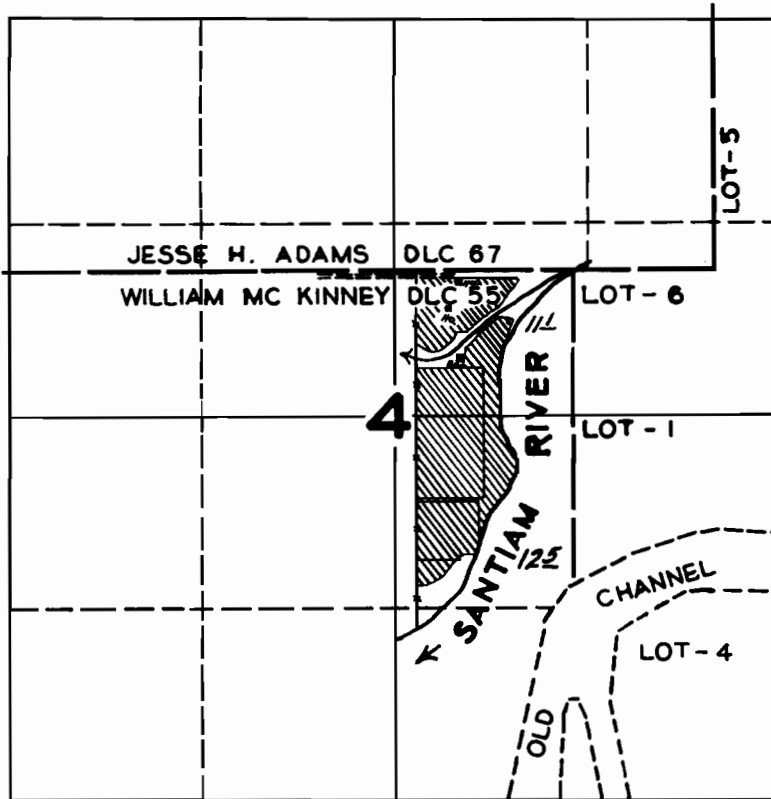

**FINAL PROOF SURVEY**  
UNDER

Application No. 18825 Permit No. 14463

IN NAME OF  
**W. S. MC. LOUD**

Surveyed JUNE 5 1944 by *[Signature]*