T. 6 S. R. 1 E. W. M.

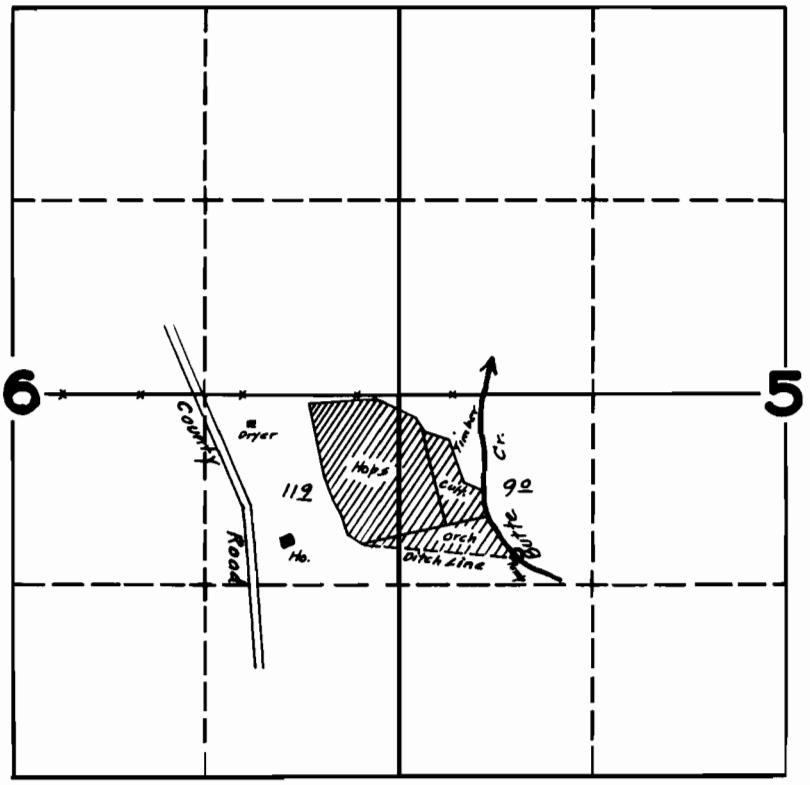

FINAL PROOF SURVEY

UNDER

Application No. 18833 Permit No. 14470

IN NAME OF

G.G. WHITE

Surveyed JUNE 13 1944 by [illegible]

1944 – A