


T6S. R I W. W.M.

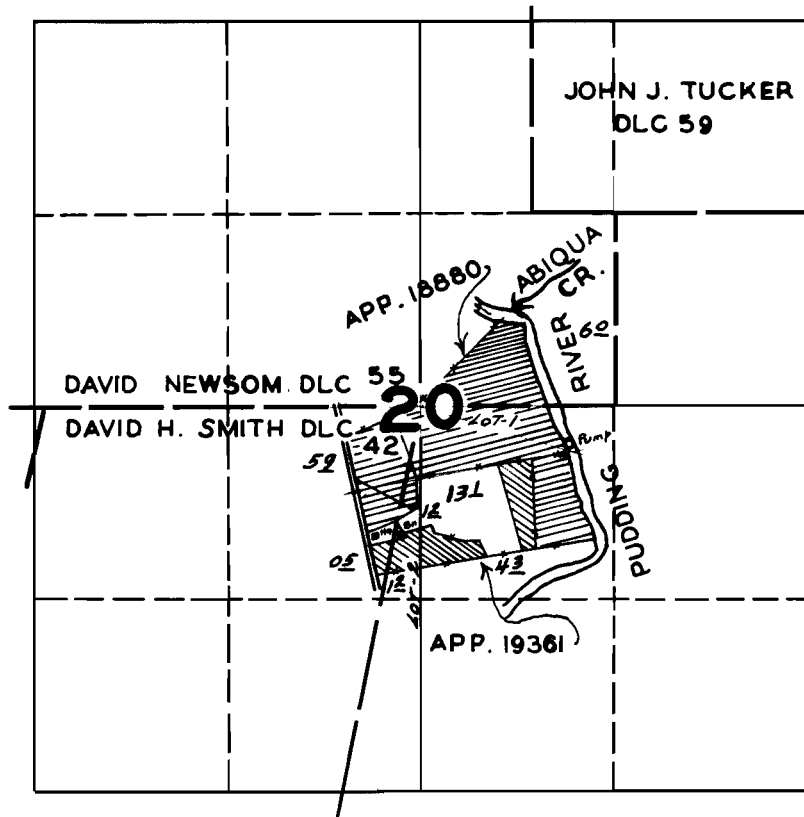

FINAL PROOF SURVEY

UNDER

18880 14385
Application No. 19361 Permit No. 14945

IN NAME OF

JOHN H. FICK

Surveyed JUNE 9, 1944, by