


T.6N.R.2W.W.M.

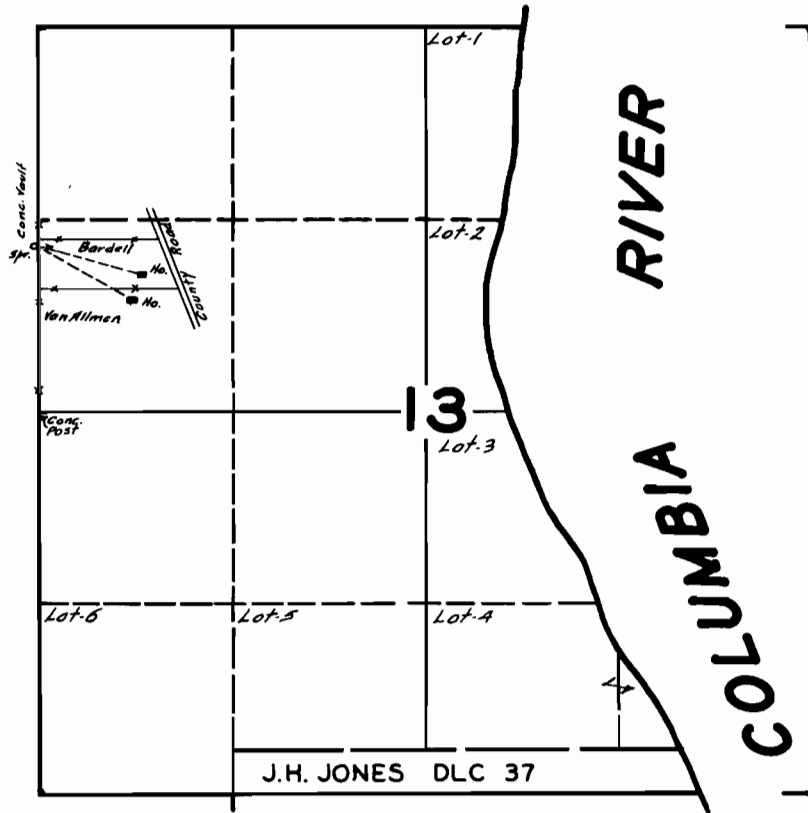

FINAL PROOF SURVEY
UNDER

Application No. 18955 Perm. No. 14557

IN FAVOR OF

FRITZ VAN ALLMEN & CARL BARDELL

Surveyed AUG. 7, 1944, by *[Signature]*