


**T.IN. R.IOW.W.M.**

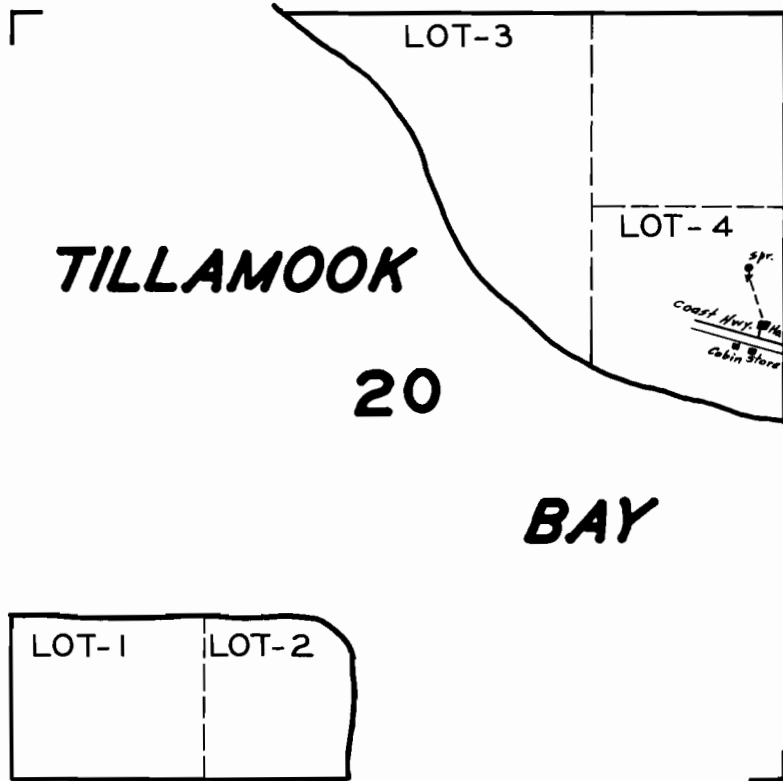

**FINAL PROOF SURVEY  
UNDER**

Application No. 18978 Permit No. 14573

IN NAME OF

**C. E. & LUCILLE WYMORE**

Surveyed AUG. 12, 1944, by *James Sumrell*