


T.4S. R.4W.W.M.

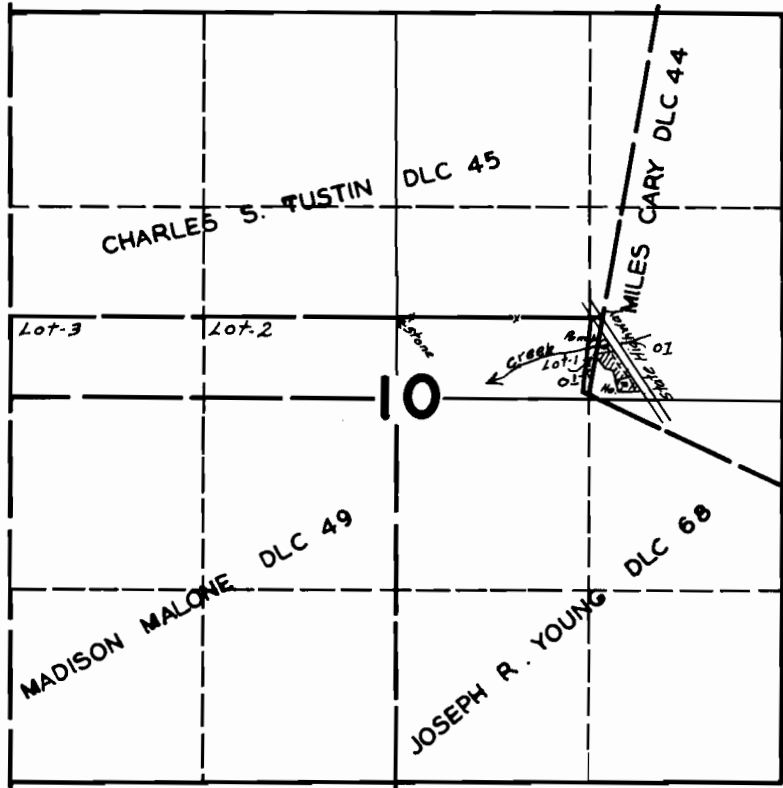

FINAL PROOF SURVEY

UNDER

Application No. 18984 Permit No. 14575

IN NAME OF

CHAS. O. & LYDA A. EDWARDS

Surveyed JUNE 26 1944, by *[Signature]*