


T.4N. R.10W.W.M.

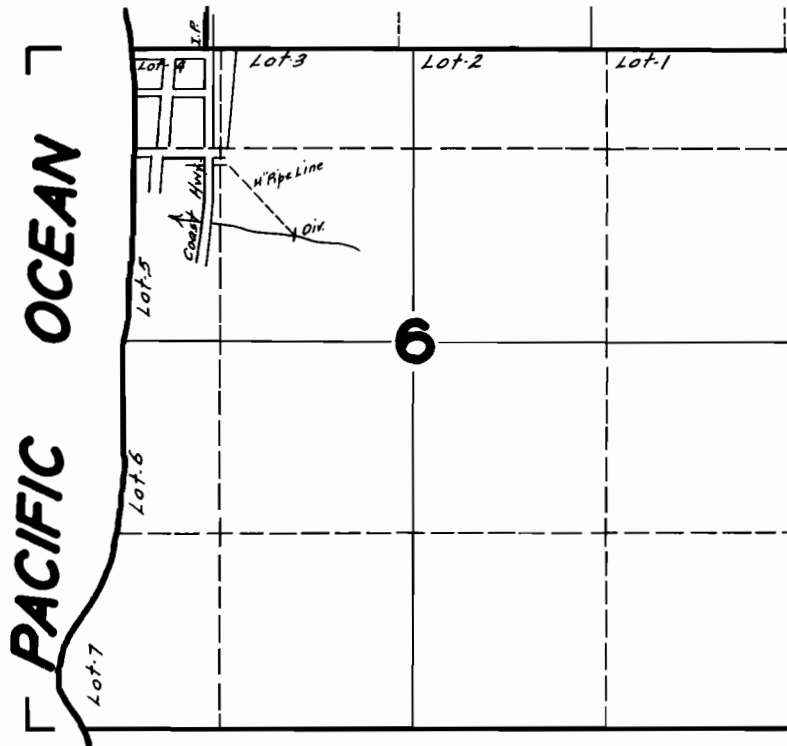

FINAL PROOF SURVEY
UNDER

Application No. 18999 Permit No. 14613

IN NAME OF

WAVE CREST WATER USERS ASSOC.

Surveyed AUG. 11 1944 by *W. E. Sumrell*