


# T.5S. R.1E.W.M.

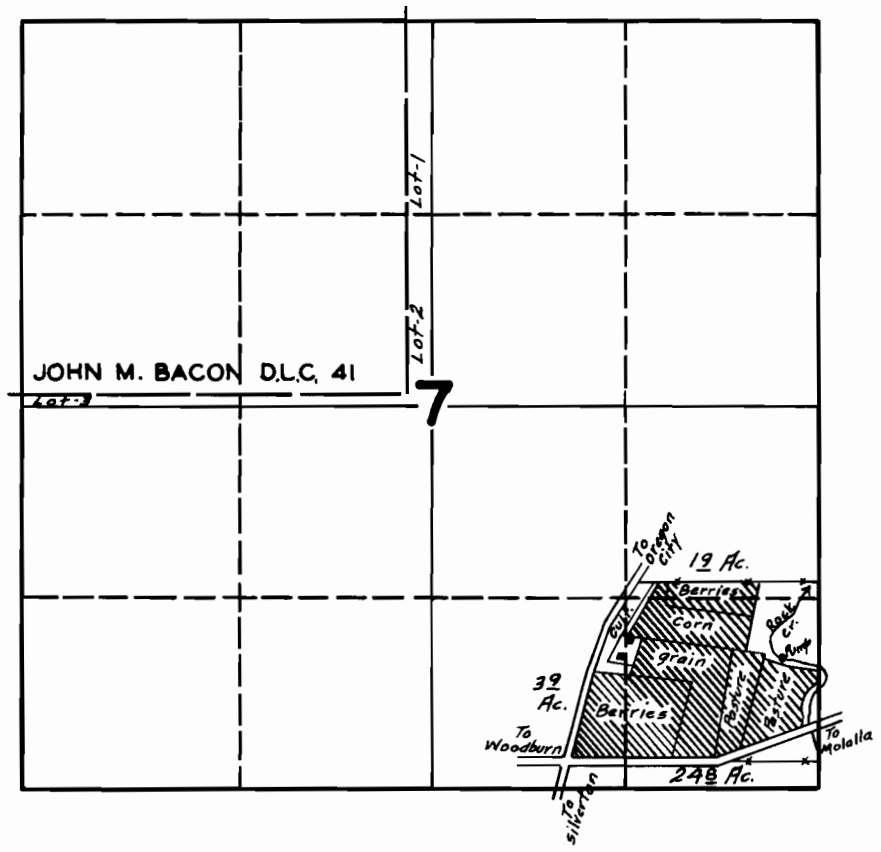

## FINAL PROOF SURVEY UNDER

Application No. 19006 Permit No. 14618

BY

**WILFORD A. NELSON**

Surveyed AUG. 24 1944, by *[Signature]*