


T.9S. R.3E. W.M.

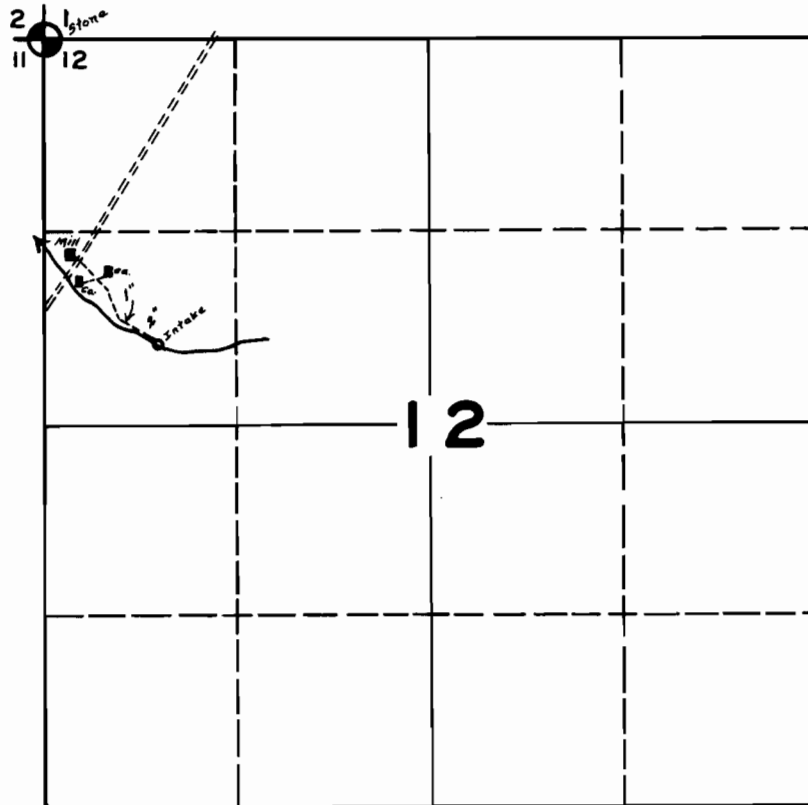

**FINAL PROOF SURVEY
UNDER**

Application No. 19012 Permit No. 14623

IN NAME OF

MEHAMA LUMBER CO.

Surveyed JUNE 23 1944, by

James C. Runnell