


T.3N. R.2W.W.M.

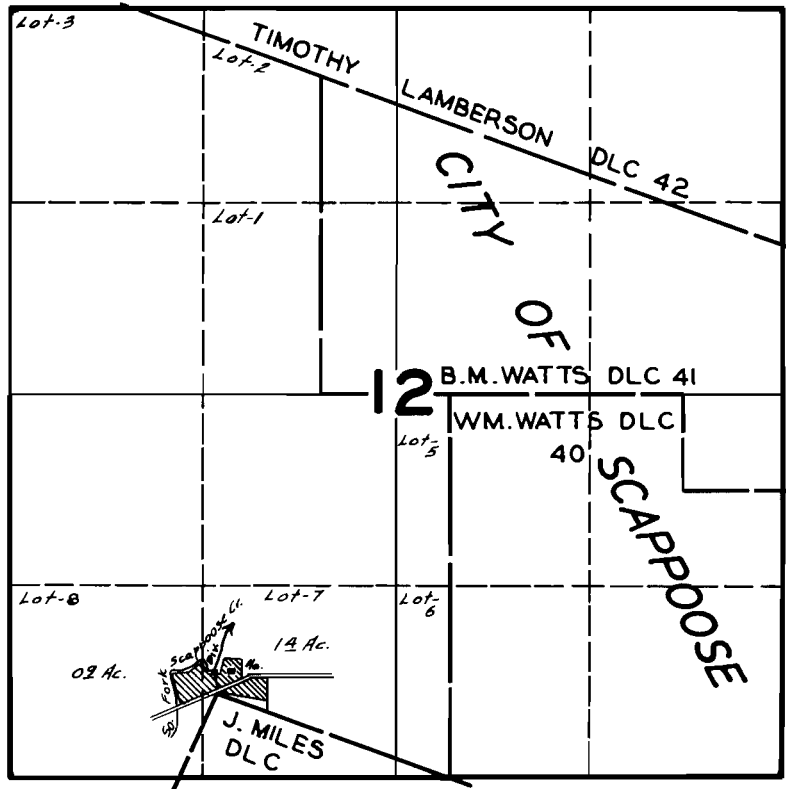

FINAL PROOF SURVEY UNDER

Application No. 19199 Permit No. 14795

FORREST A. KLUM

Approved AUG. 8 1944, by *[Signature]*