


T.8S. R.4W.W.M.

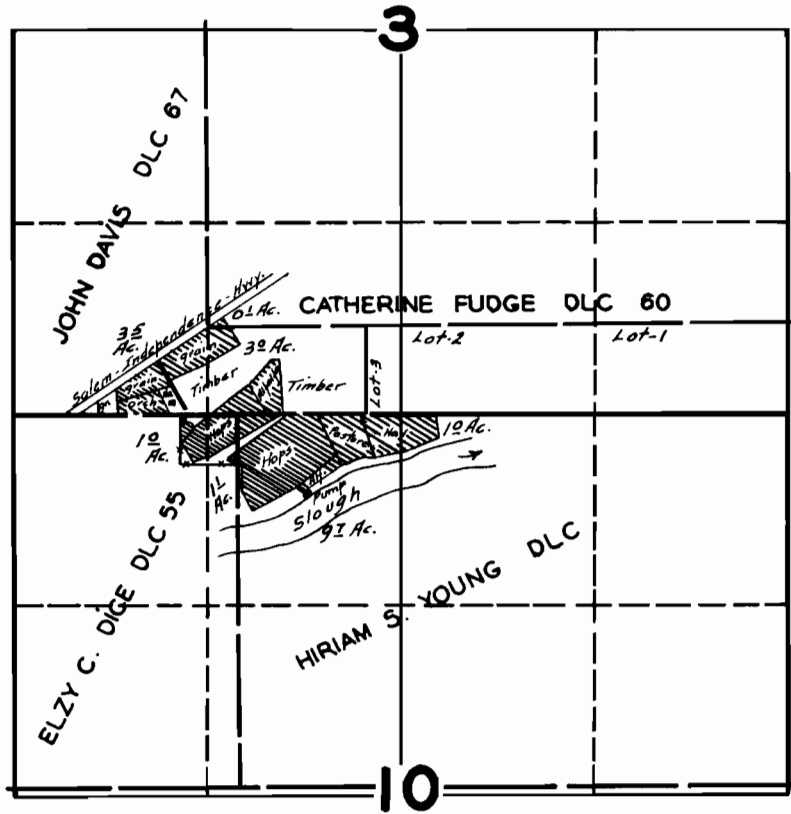

FINAL PROOF SURVEY UNDER

Application No. 19205 Permit No. 14799

Filed for

E. A. & GLADYS HARNSEBERGER

Surveyed SEPT. 2, 1944, by *J. L. Sumrell*