


T.4S. R.4W.W.M.

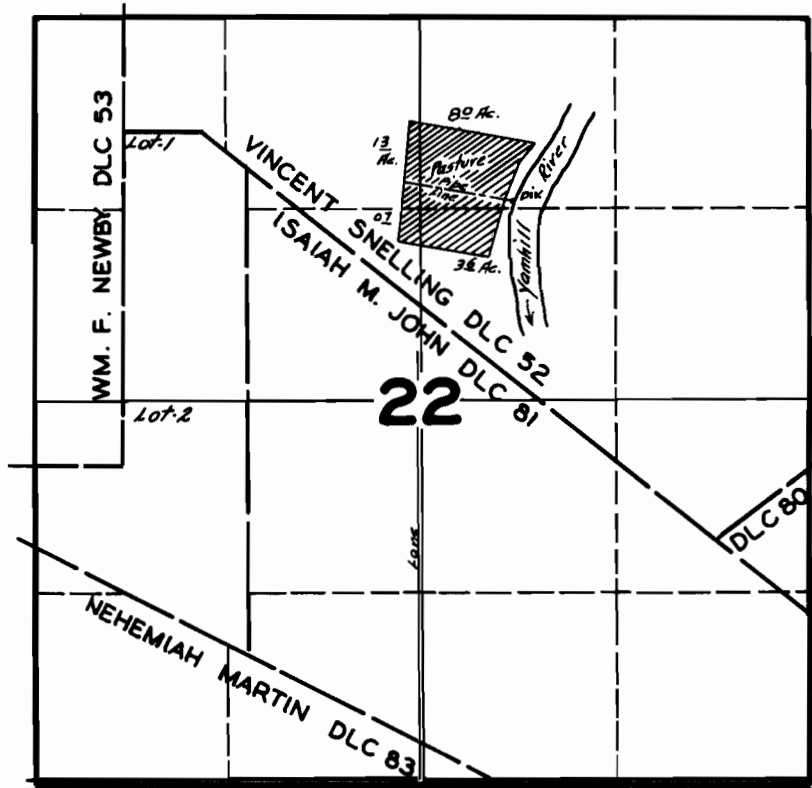

FINAL PROOF SURVEY UNDER

Application No. 19244 Permit No. 14826

IN NAME OF
ED. SOHRWEID

Surveyed JAN. 27 1945, by [Signature]