


T.6S. R.6W.W.M.

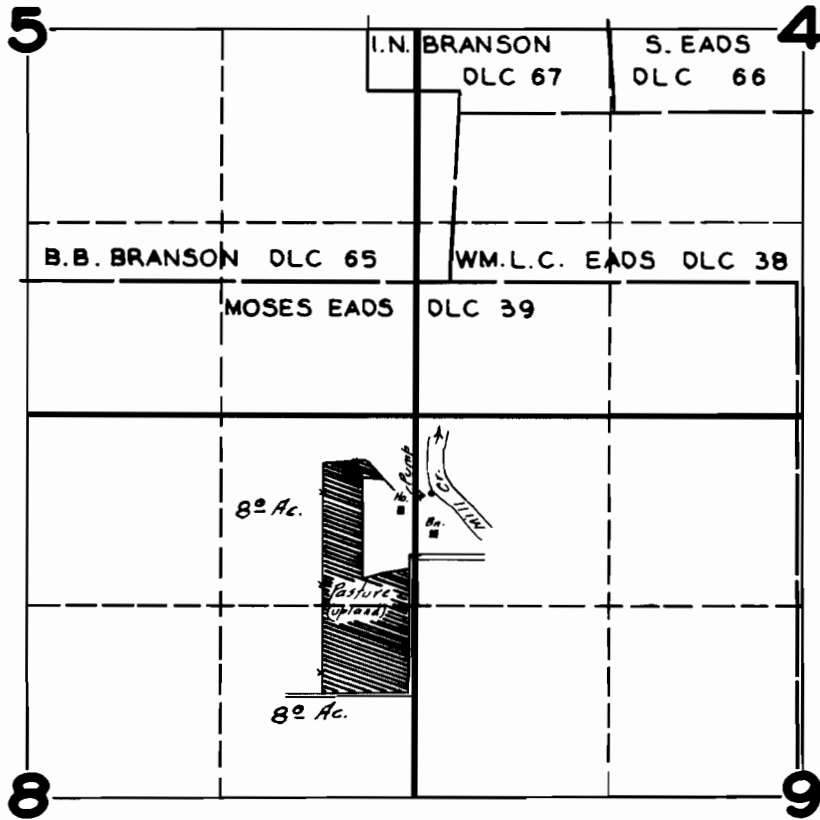

FINAL PROOF SURVEY UNDER

Application No. 19275 Permit No. 14869.

IN FAVOR OF

WM. ROSENBALM,

Surveyed AUG. 17 1944, by *[Signature]*