


T.7S. R.3W.W.M.

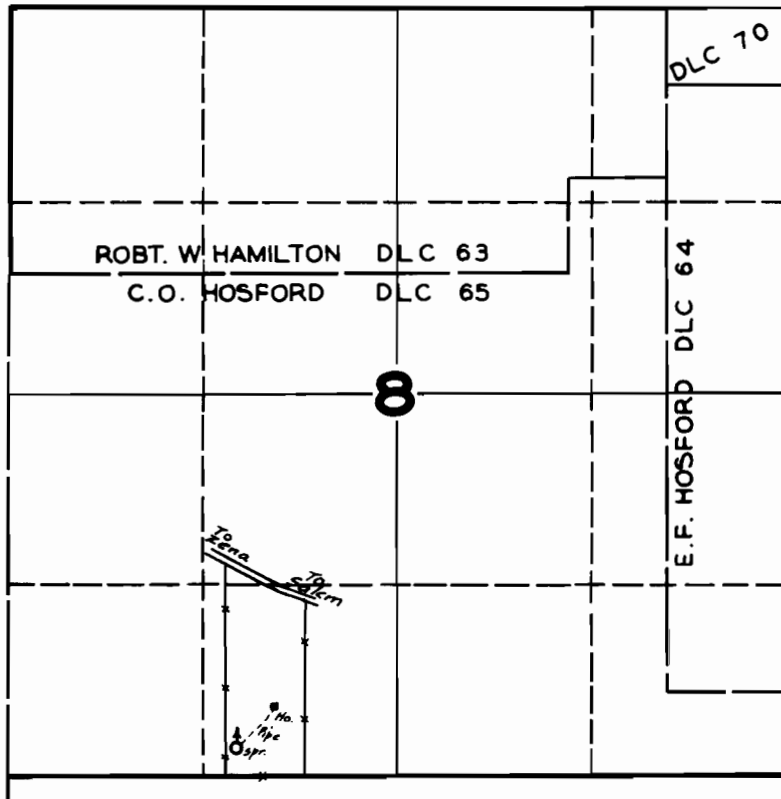

FINAL PROOF SURVEY

UNDER

Application No. 19280 No. 14873

IRMA GRACE TURNER

Surveyed AUG. 19 1944, by *[Signature]*