


# T.7&8S. R.3W.W.M.

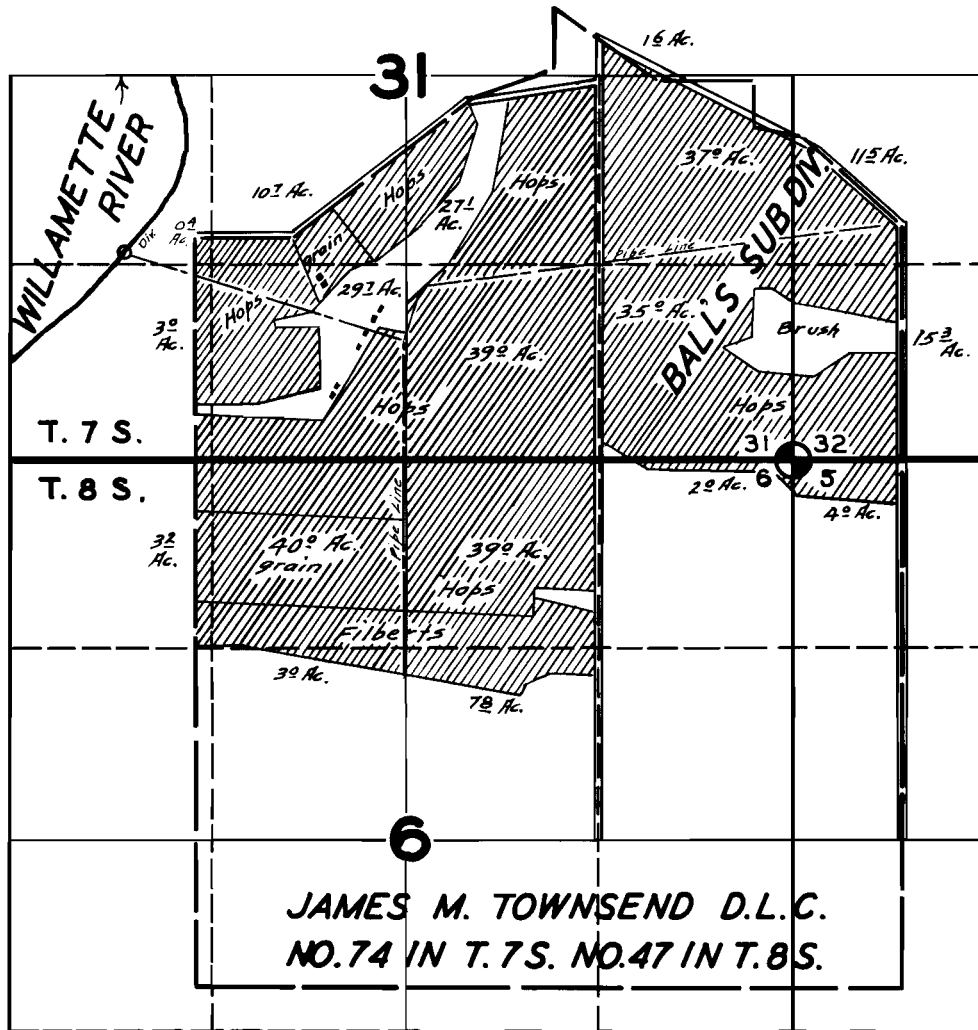

## FINAL PROOF SURVEY UNDER

Application No. 19281 Permit No. 14874

IN NAME OF

JOHN J. ROBERTS & CO.

