


T.3S. R.1E.W.M.

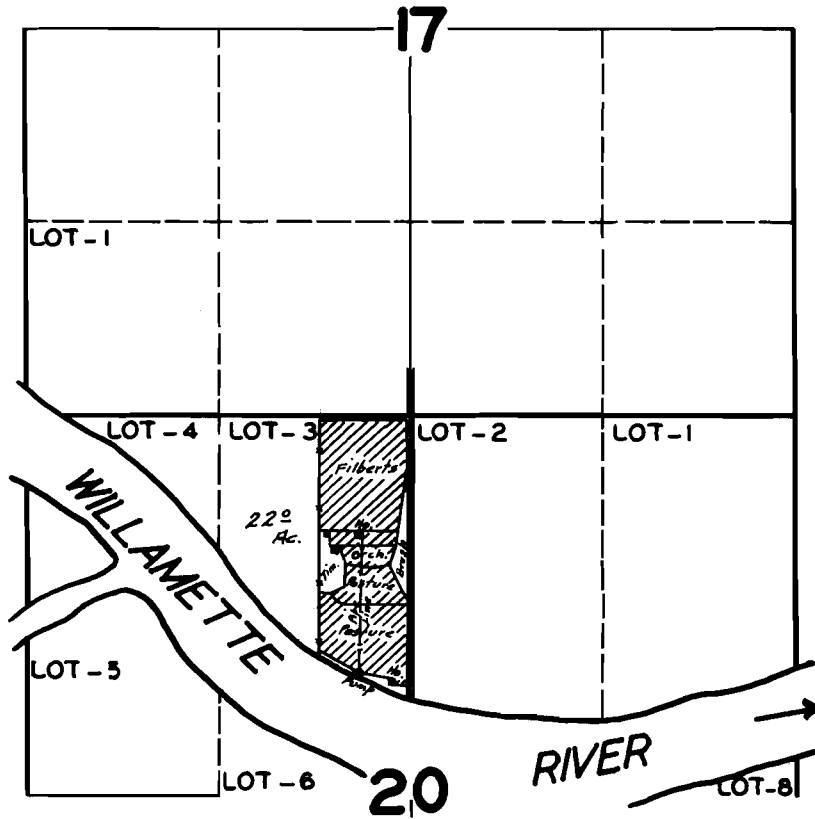

FINAL PROOF SURVEY
UNDER

Application No. 19297 Permit No. 14884

IN NAME OF

JOSEPH R. GERBER

Surveyed SEPT. 1, 1944, by [Signature]