


T.3&4S. R.1W.W.M.

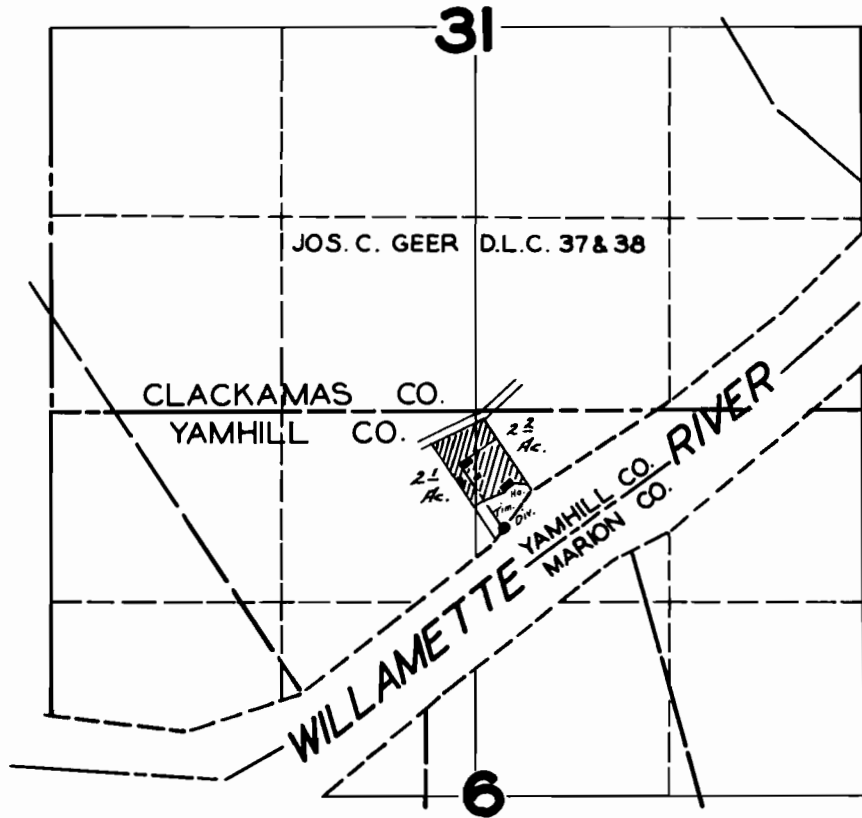

FINAL PROOF SURVEY UNDER

Application No. 19319 Permit No. 14901

IN NAME OF

E. C. SAMMONS

Surveyed AUG. 23 1944, by