


T.8S. R.4W.W.M.

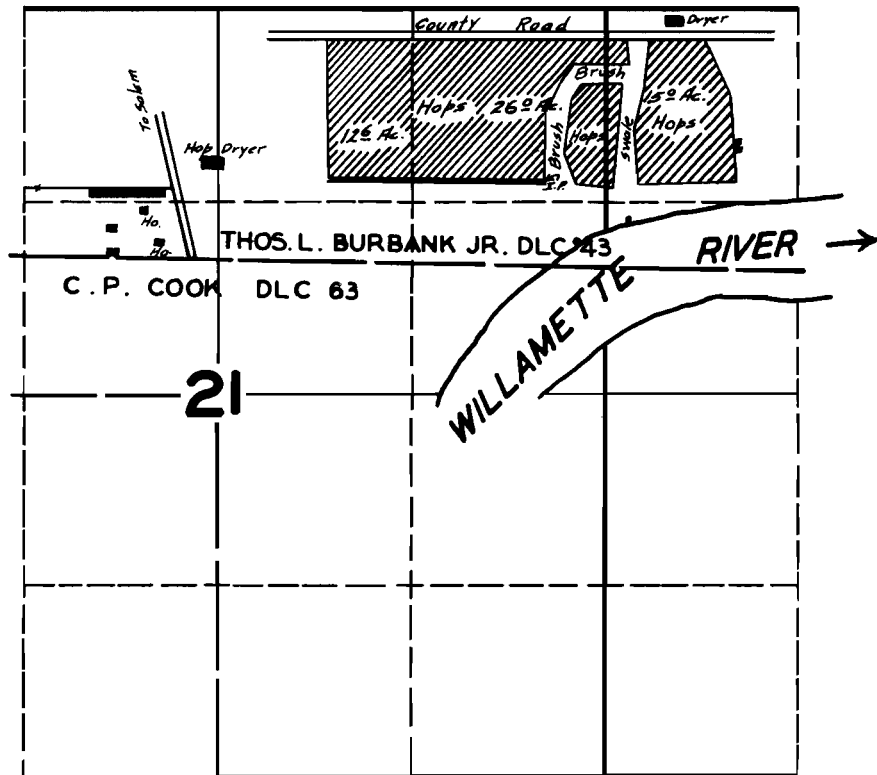

FINAL PROOF SURVEY UNDER

Application No. 19323 Permit No. 14903

IN FAVOR OF

S. J. HOOVER & SON

Surveyed SEPT. 14 1944, by [Signature]