


# T.3S. R.IE.W.M.

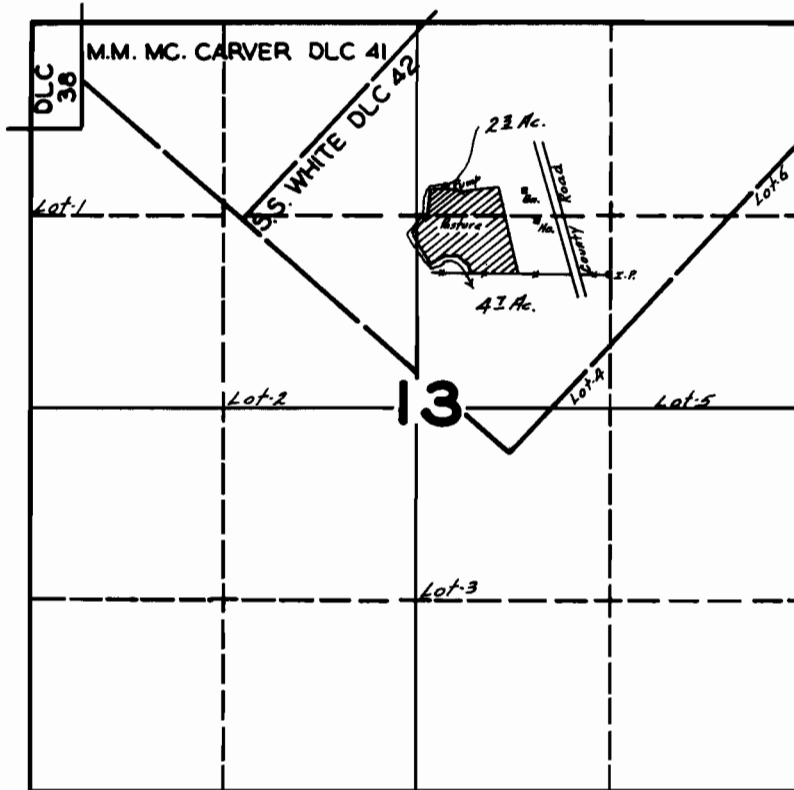

## FINAL PROOF SURVEY UNDER

Application No. 19413 Permit No. 14969

IN NAME OF

WALTER MILLER

Surveyed AUG. 31, 1944, by *[Signature]*