


T.4S. R.3W.W.M.

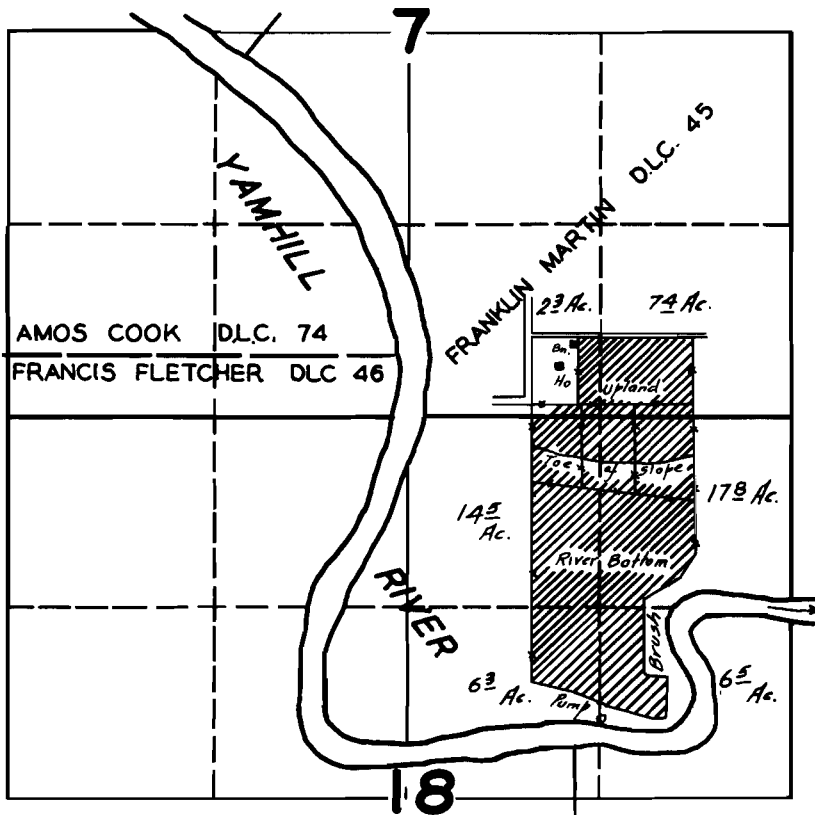

FINAL PROOF SURVEY

UNDER

Application No. 19401 Permit No. 14978

IN NAME OF

E. MILES MAXWELL

Surveyed AUG. 21, 1944, by