


T.3&4S. R.3W.W.M.

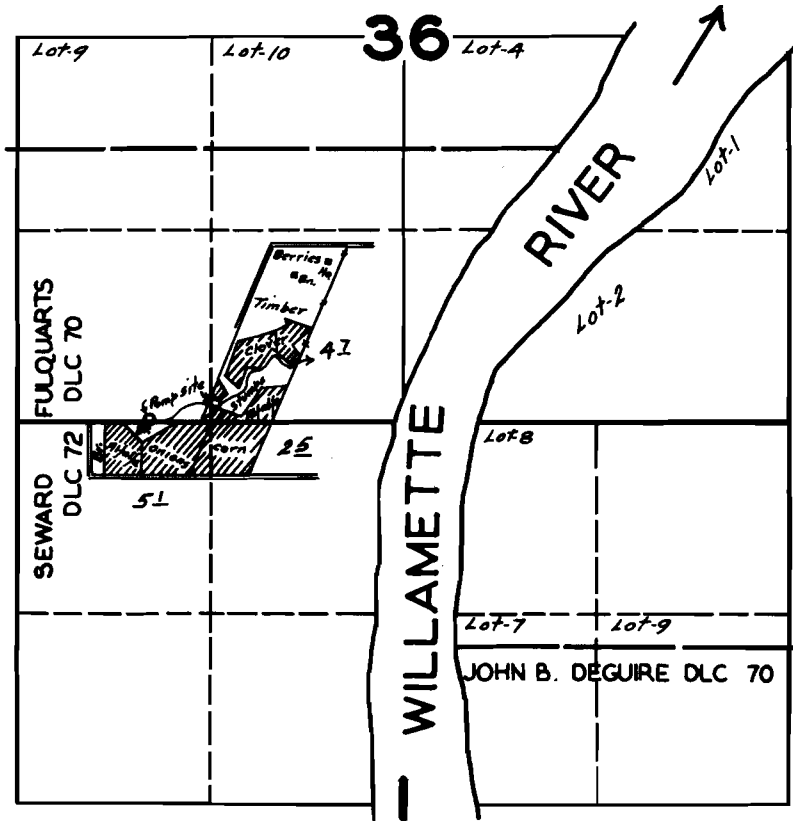

FINAL PROOF SURVEY UNDER

Application No. 19400 Permit No. 14979

IN NAME OF

E. L. VAN DYKE

Surveyed JULY 3, 1944, by J. L. Sumrell