

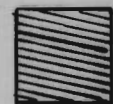


T.5S. R.6W.W.M.

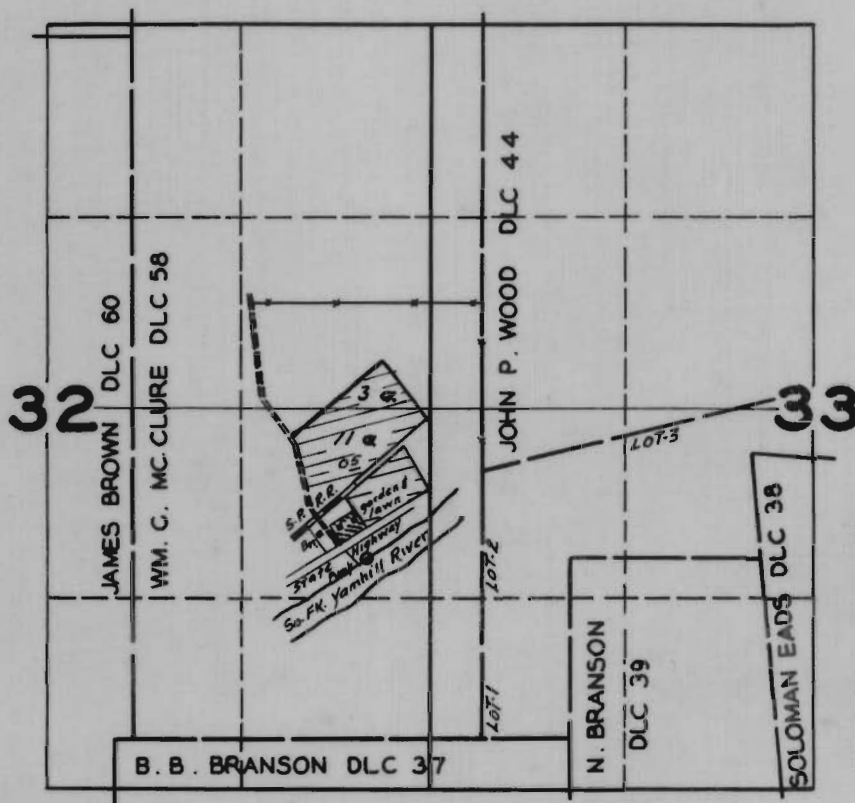

Per. No.
~~14991~~

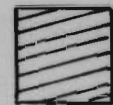

App. No.
27164

14 a.
Per. No.
21362

FINAL PROOF SURVEY UNDER

Application No. 19386 Permit No. 14991


IN FAVOR OF

ERNEST RYAN

Surveyed JULY 5 1944

James C. Russell

T.5S. R.6W. W.M.

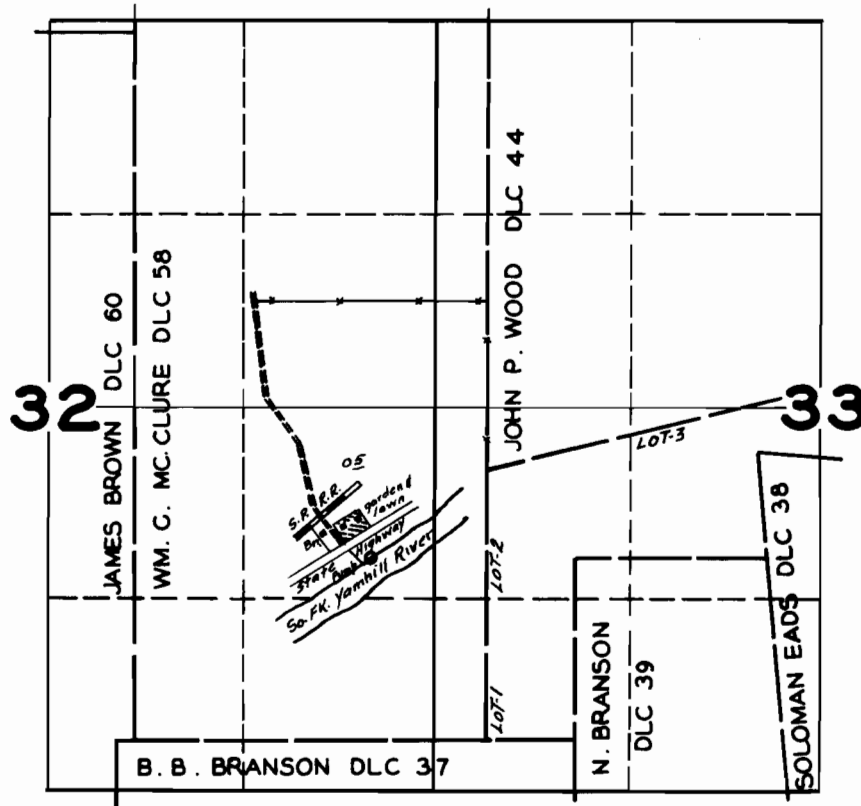

FINAL PROOF SURVEY UNDER

Application No. 19386 Permit No. 14991

IN NAME OF
ERNEST RYAN

Surveyed JULY 5, 1944, by *James Russell*