


T.6S. R.8W.W.M.

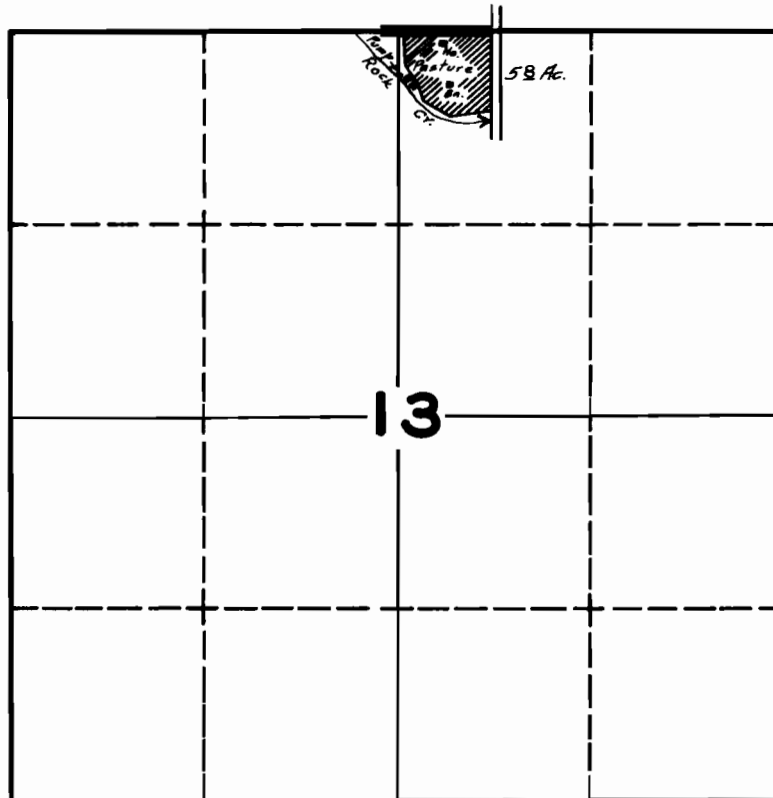

FINAL PROOF SURVEY

UNDER

Application No. 19433 Permit No. 15032

IN NAME OF

H.D. BANKS

Surveyed AUG. 16, 1944, by *[Signature]*